Kerrigan & Essex Company

PLATE 3 CROSS SECTION NOTES Made in U.S.A.

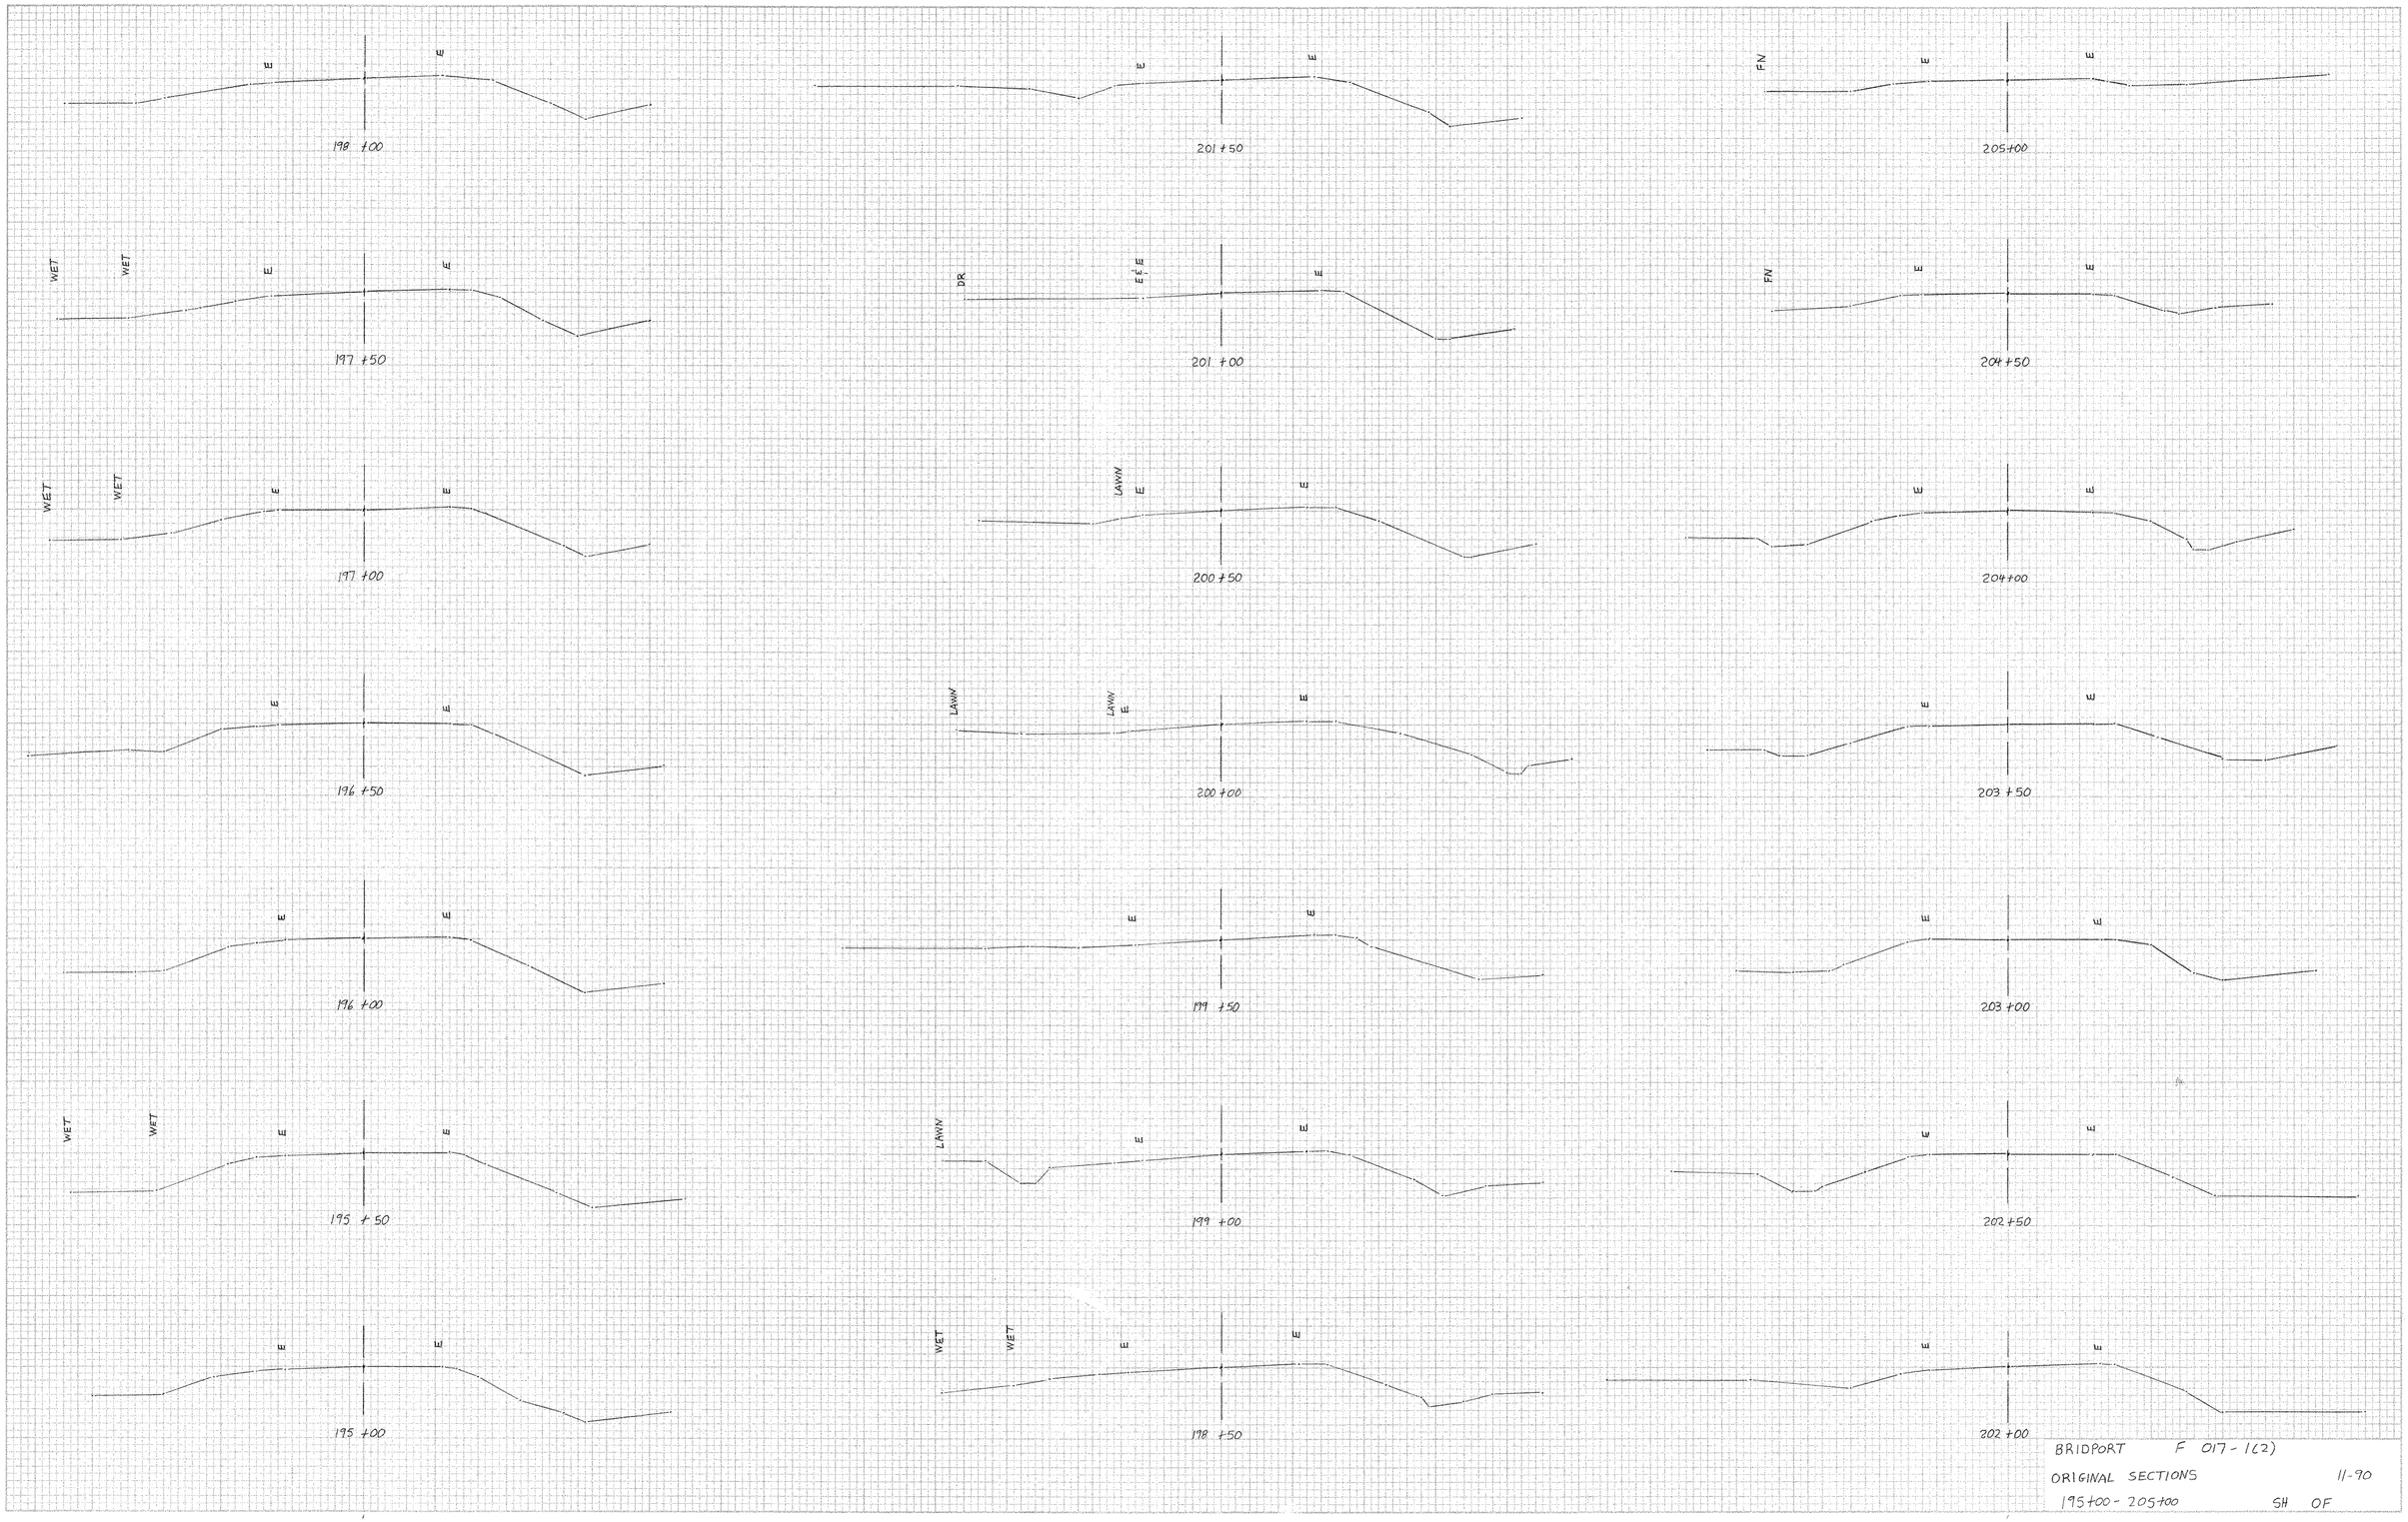

BRIDPORT F 017-1(2)

ORIGINAL SECTIONS 11-90

195+00 - 205+00 SH OF

514 ORIGINAL