Keuffel & Esser Company PLATE 3. CROSS SECTION 48 TO 100 Made in U.S.A.

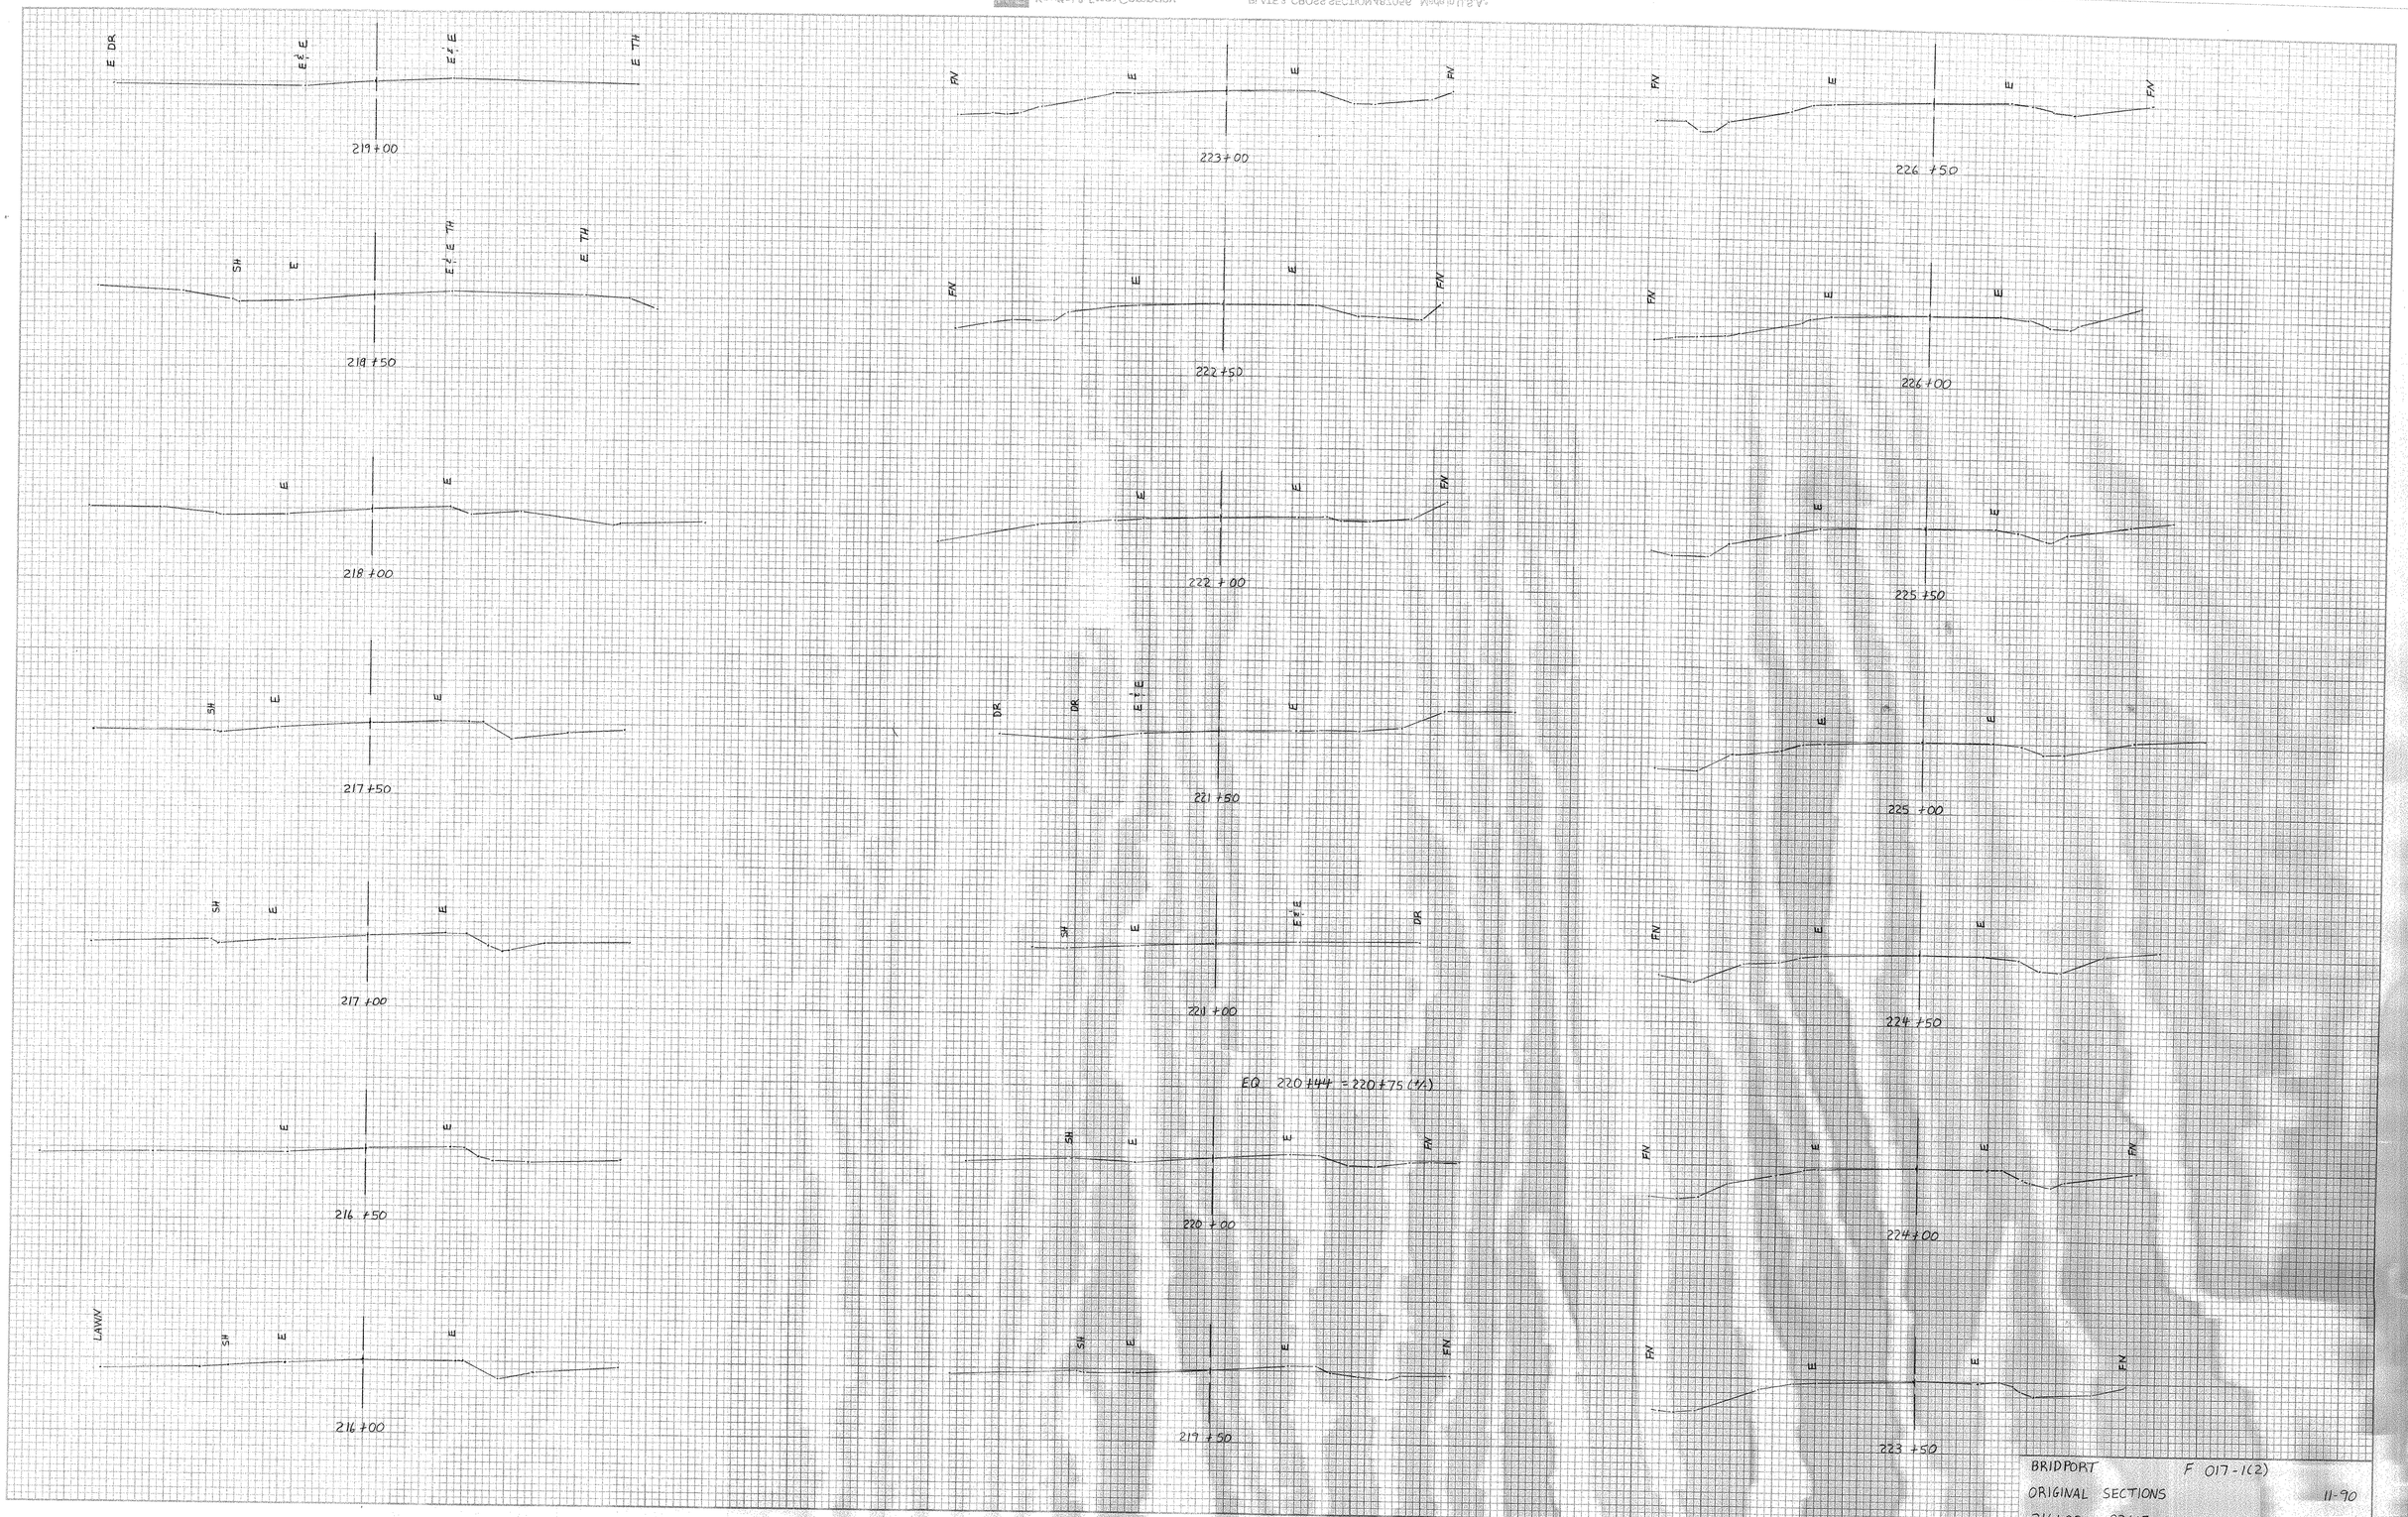

EQ 220+44 = 220+75 (4%)

NO	REVISIONS	CHECKED	
		APPR'D	
		DATE	