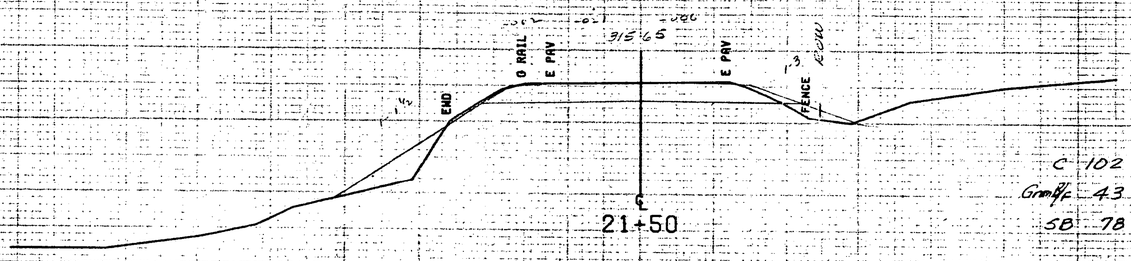

C 102
Gram/C 43
58 78

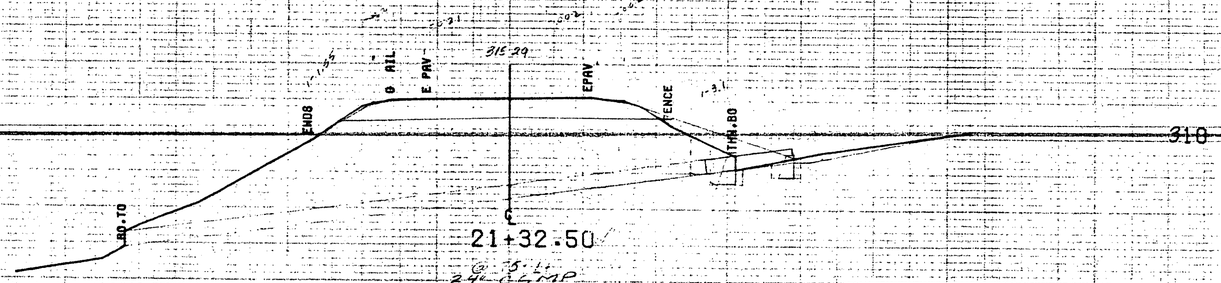

@ 75' Lt.
24" CL/MP
RETAIN & EXTEND with
New 24"x 12" ACC/MP .064
w/ Craddle Headwall @ Inlet

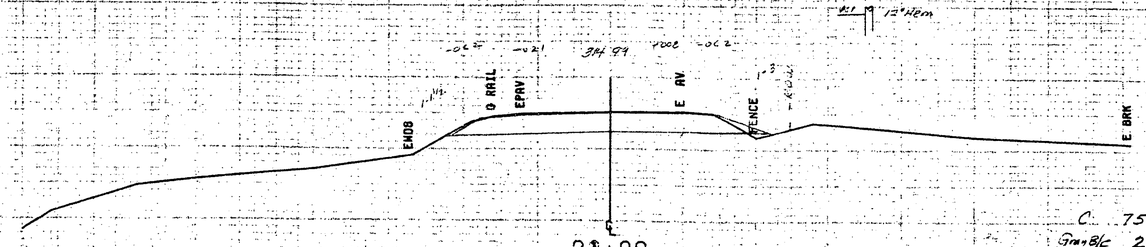

C 75
Gram/C 2
58 78

FROM STA.	21+00	TO STA.	21+50
PROJECT NAME	JERICHO	R VER	
NO.	RS0224(3)	PLOTTED	01/17/84
SURVEYED BY	BEARD	JAN 1984	
SHEET 24 OF 60 SHEETS			

SCALE 10 FEET