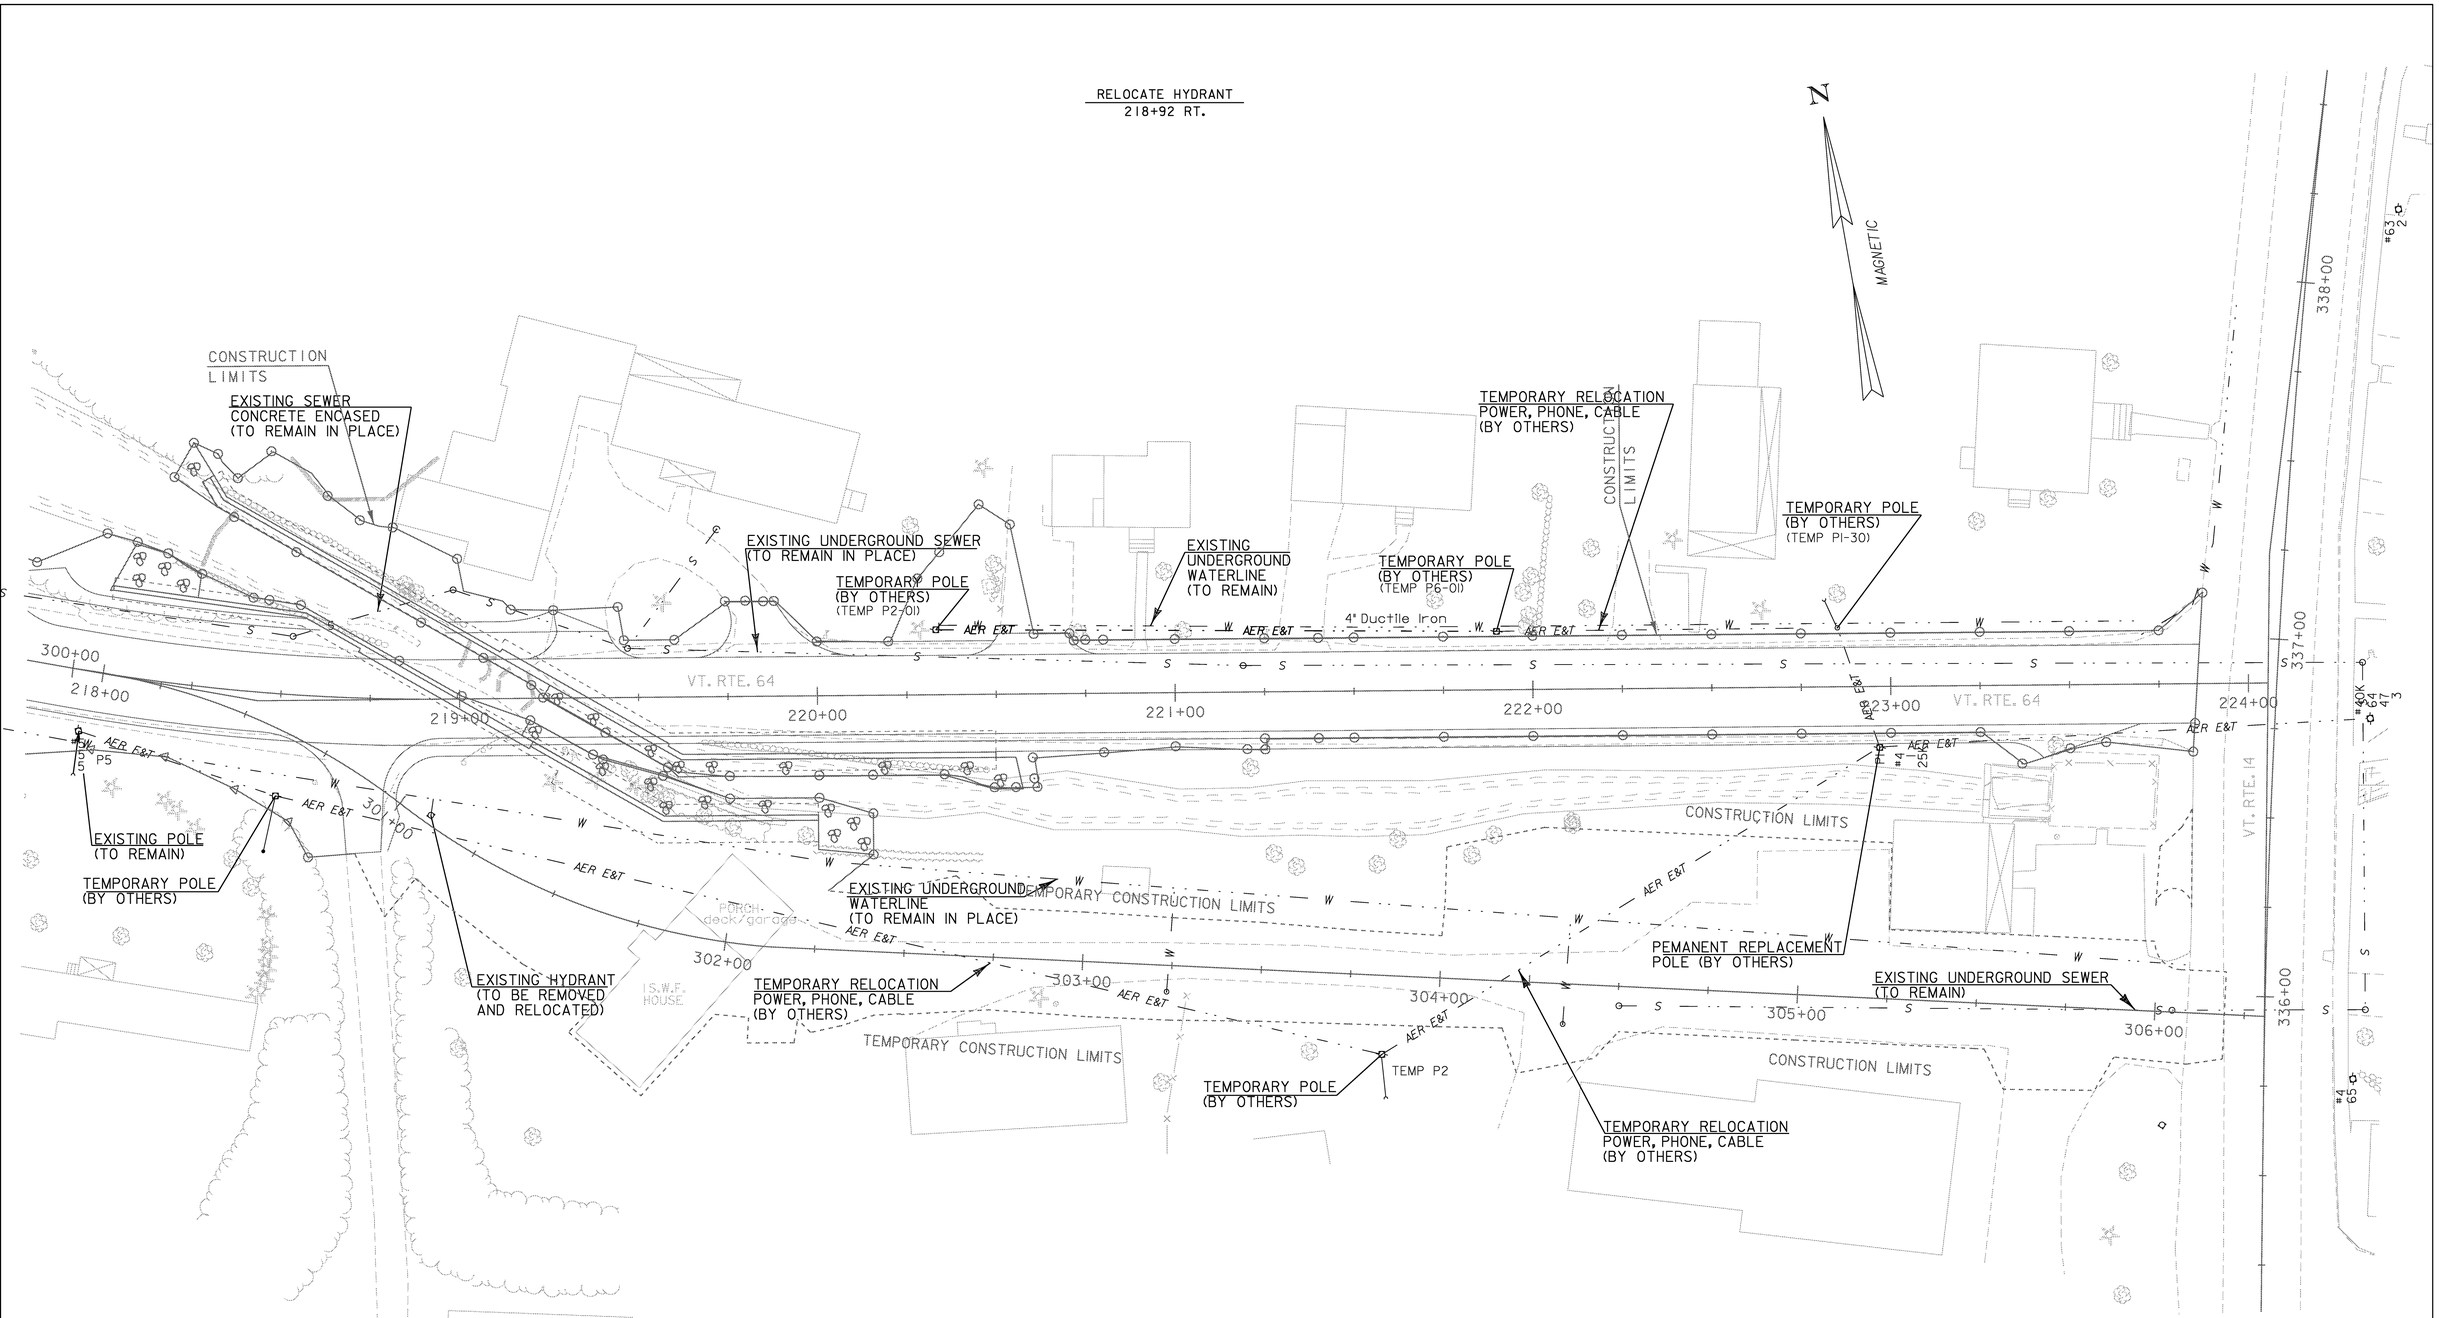

UTILITY LAYOUT SHEET

PROJECT: WILLIAMSTOWN	PROJECT NO.: BRS 0204(4)
DESIGN FILE NAME: /projects/83elll/sellldtr.dgn	
IPARM FILE NAME: s83elldtrl	PLOT DATE: 07-APR-2008
SURVEYED BY: GILMAN	SURVEY DATE: 9/89
SQUAD LEADER: M. EVANS-MONGEON	DRAWN BY: U. STANLEY
	SHEET: 24 OF 108

DATUM	
VERTICAL	NGVD 1929
HORIZONTAL	ASSUMED