REMOVING SIGNS
(NARROW BRIDGE/ 600 FT) ℳ STA 212+75 RT
(NARROW BRIDGE) ℳ STA 216+55 RT
(OBJECT MARKER RIGHT) ℳ STA 219+18 RT
(OBJECT MARKER LEFT) ℳ STA 219+22 LT
(OBJECT MARKER RIGHT) ℳ STA 219+72 RT
(THROUGH WAY BEGINS HERE/ SPEED LIMIT 25) ℳ STA 220+10 LT
(END/ VERMONT 64) ℳ STA 221+60 RT
(NARROW BRIDGE/ 300 FT) ℳ STA 222+00 LT
(WEST/ VERMONT 64) ℳ STA 223+00 LT
(STOP) ℳ STA 223+60 RT (BROOK ST)
(WEST/ VERMONT 64) DETOUR STA 303+09 LT
(END/ VERMONT 64) DETOUR STA 304+00 RT
(STOP) DETOUR STA 306+00 RT /MM PLAQUE
(DIRECTIONAL SIGN 3) VT 14 STA. 335+70 RT
(DIRECTIONAL SIGN 2) VT 14 STA. 336+11 RT
(DIRECTIONAL SIGN 3) VT 14 STA. 336+48 RT
(DIRECTIONAL SIGN 1) VT 14 STA. 336+64 LT
(DIRECTIONAL SIGN 2) VT 14 STA. 336+88 RT
(DIRECTIONAL SIGN 1) VT 14 STA. 337+89 LT

DURABLE 4 INCH YELLOW LINE (DOUBLE)
ℳ STA 215+00 TO STA 223+85

DURABLE 4 INCH WHITE LINE
ℳ STA 215+00 TO STA 223+85 RT
ℳ STA 215+00 TO STA 223+85 LT

DURABLE 24 INCH STOP BAR
ℳ STA 223+75 RT

DURABLE LETTER OR SYMBOL
(STOP) ℳ STA 223+70 RT

ERECTING SALVAGED SIGNS
(WEST/ VERMONT 64) DETOUR STA 303+09 LT
(END/ VERMONT 64) DETOUR STA 304+00 RT
(STOP) DETOUR STA 306+00 RT
(DIRECTIONAL SIGN 3) VT 14 STA. 335+70 RT
(DIRECTIONAL SIGN 2) VT 14 STA. 336+11 RT
(DIRECTIONAL SIGN 1) VT 14 STA. 336+64 LT
(BROOK ST) 223+60, RT
HANDICAPPED RESERVED PARKING (2) STA. DET. 305+67, LT
STA. DET. 305+75, LT

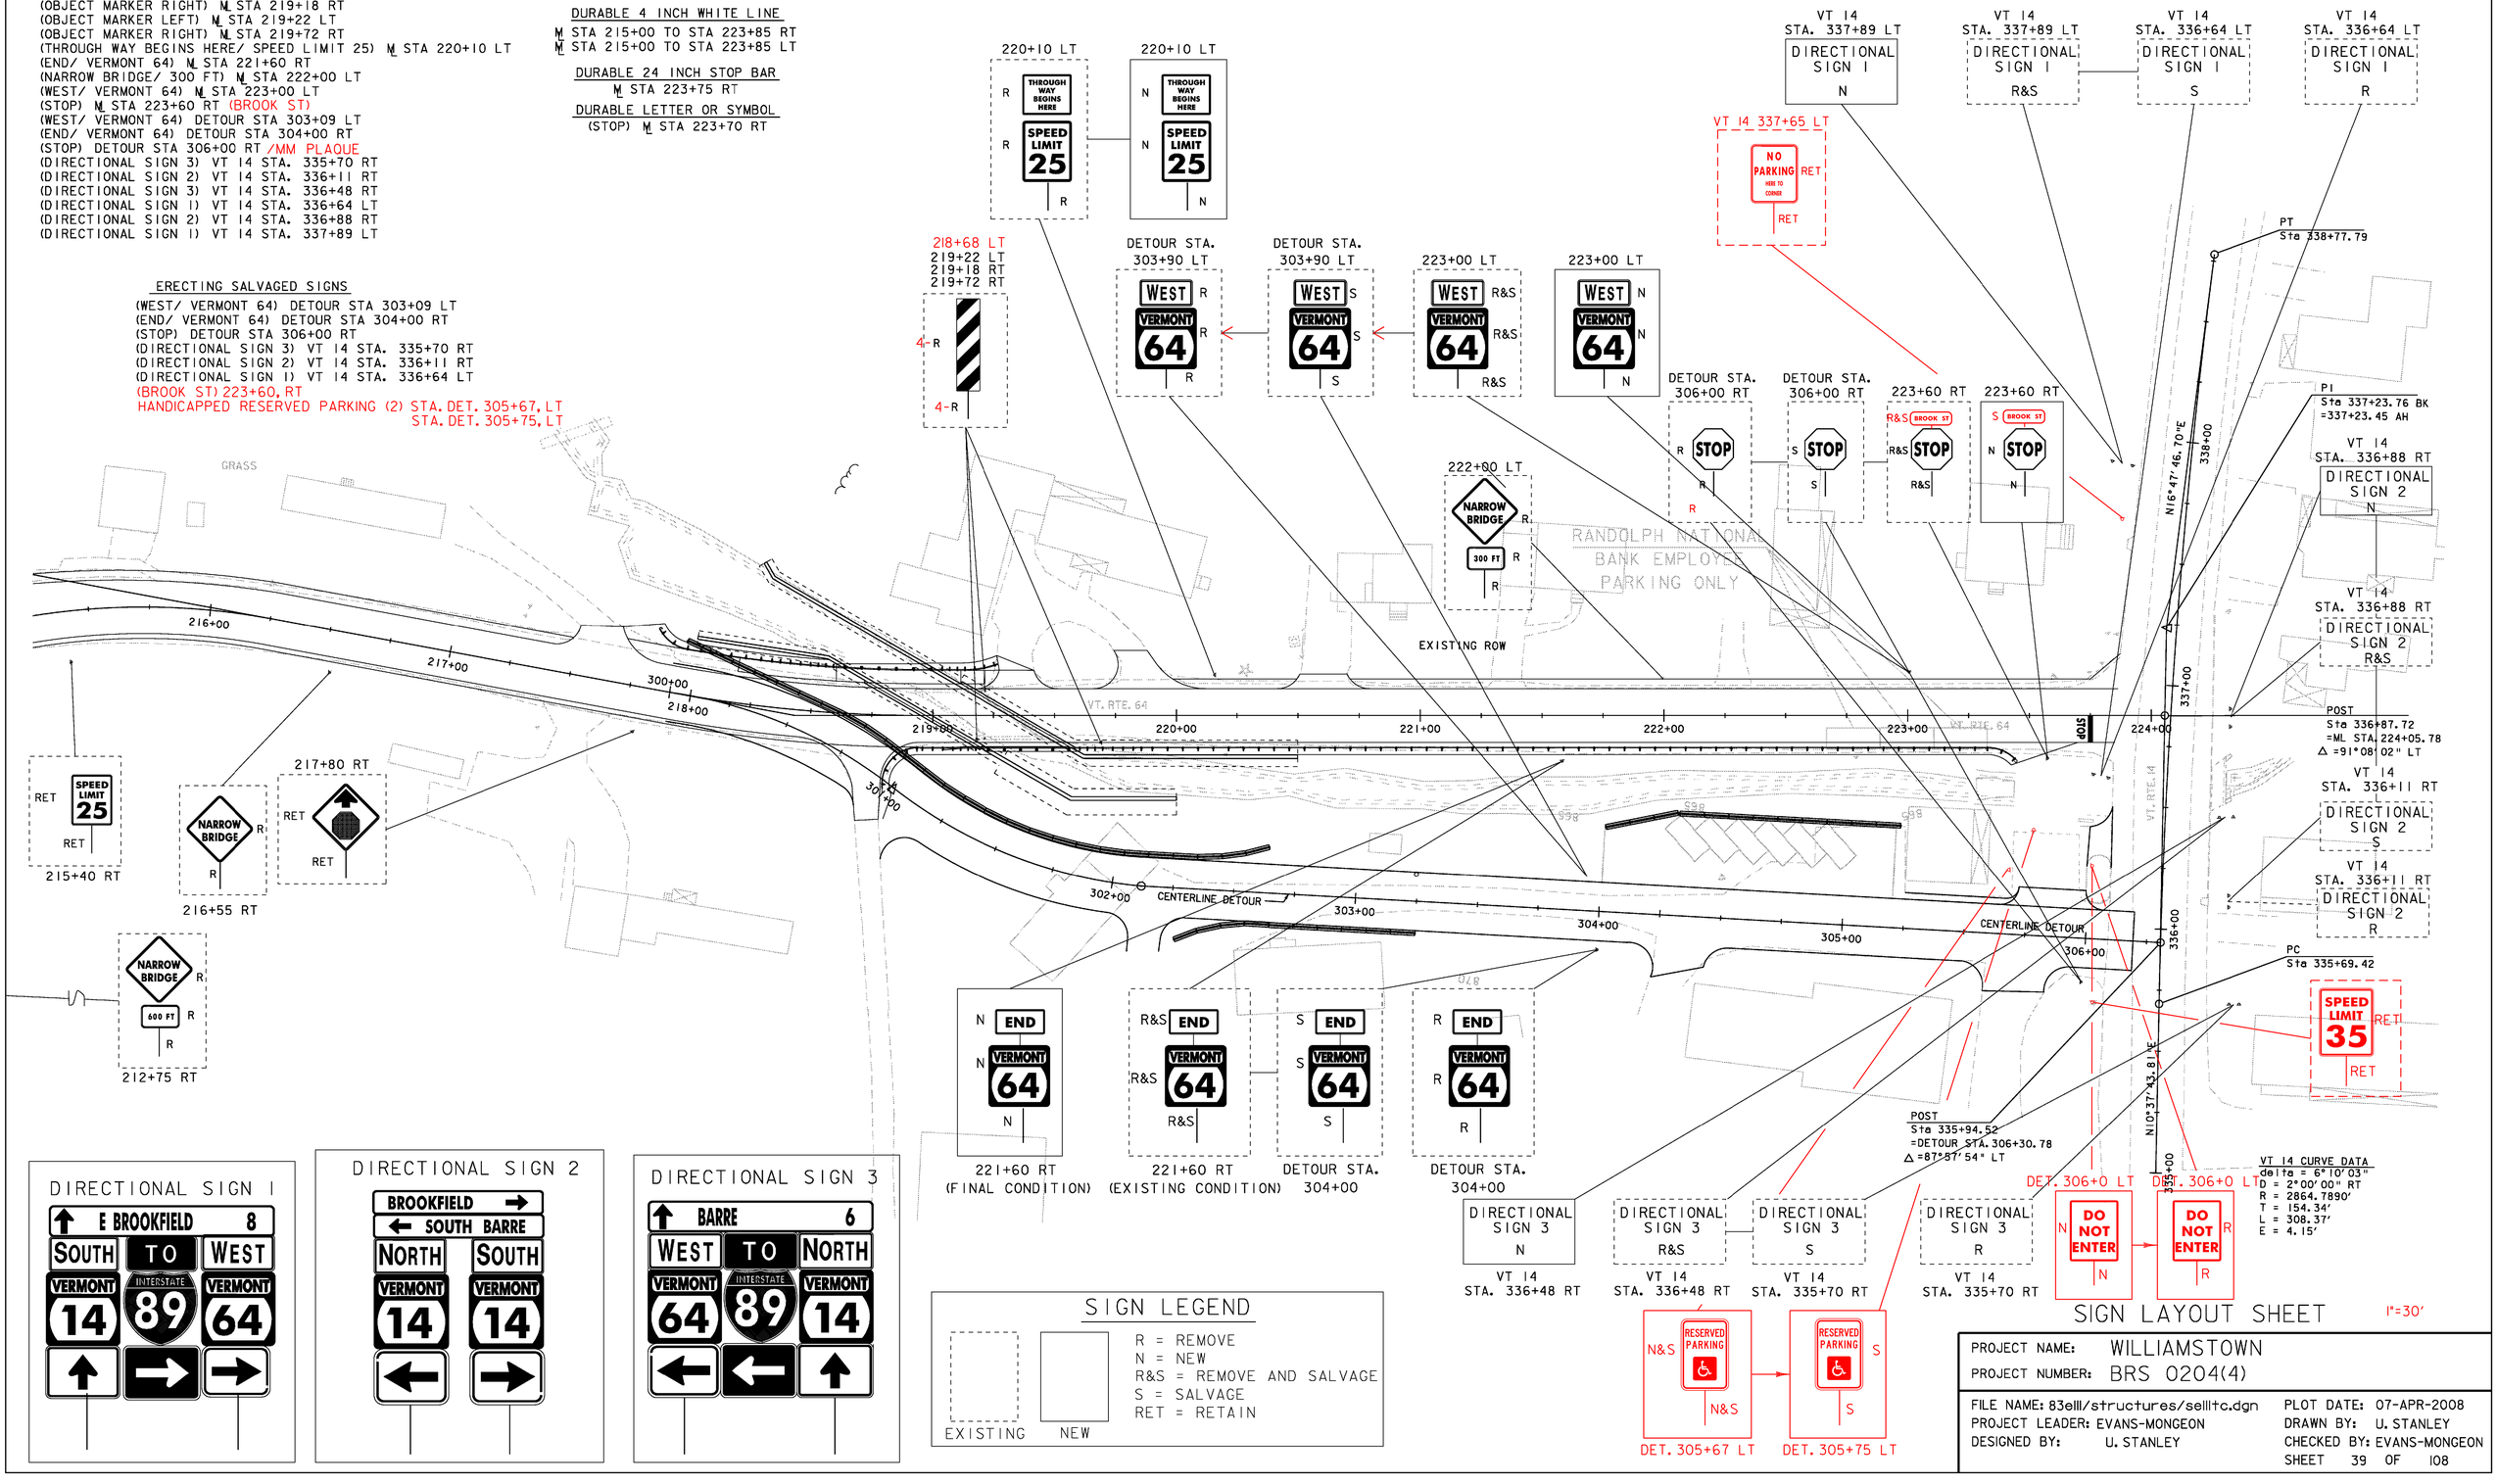


SIGN LAYOUT SHEET 1"=30'

| | |
|---|---|
| PROJECT NAME: | WILLIAMSTOWN |
| PROJECT NUMBER: | BRS 0204(4) |

FILE NAME: 83e111/structures/se111tc.dgn
PROJECT LEADER: EVANS-MONGEON
DESIGNED BY: U. STANLEY
PLOT DATE: 07-APR-2008
DRAWN BY: U. STANLEY
CHECKED BY: EVANS-MONGEON
SHEET 39 OF 108