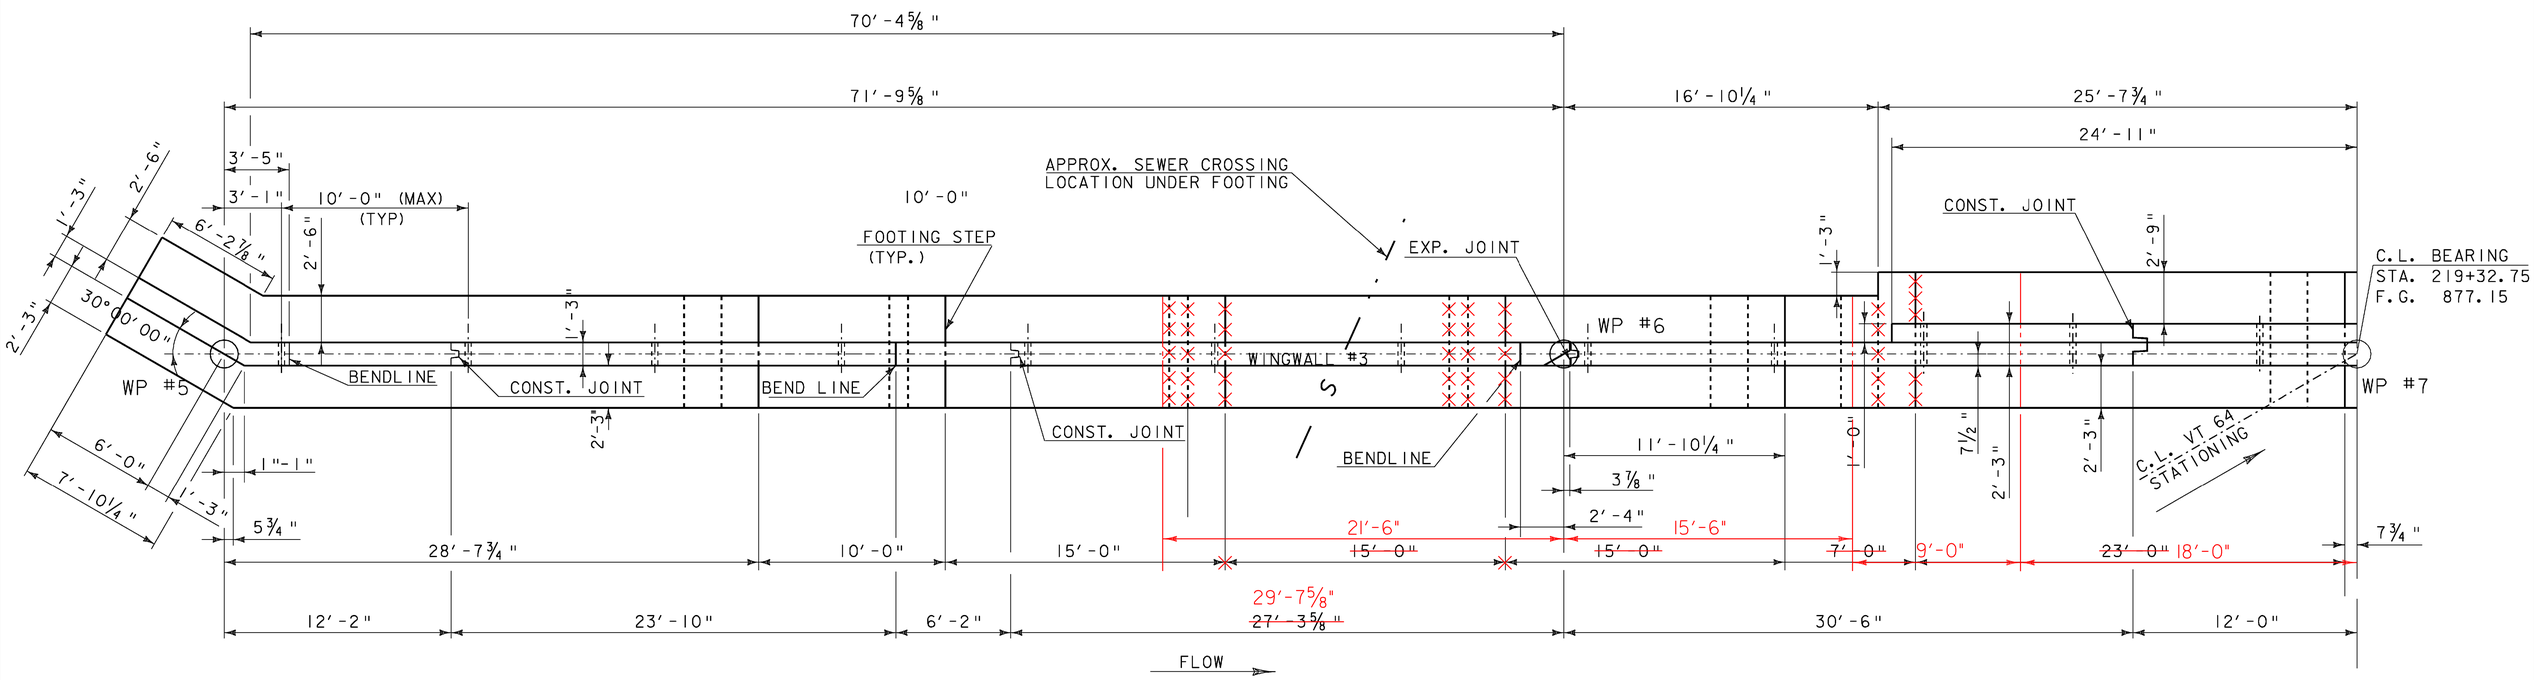


ABUTMENT #2 AND WINGWALL #3 DIMENSION PLAN

SCALE 1/4" = 1'-0

1 0 2 4 6

# ABUTMENT #2 AND WINGWALL #3 LAYOUT

| | |
|---|---|
| PROJECT NAME: | WILLIAMSTOWN |
| PROJECT NUMBER: | BRS 0204(4) |

| | |
|---|---|
| FILE NAME: 83ell\str\sellabut2.dgn | PLOT DATE: 07-APR-2008 |
| PROJECT LEADER: M.EVANS-MONGEON | DRAWN BY: EVANS-MONGEON |
| DESIGNED BY: M.EVANS-MONGEON | CHECKED BY: U. STANLEY |
| IPARM sellsub3.I | SHEET 55 OF 108 |