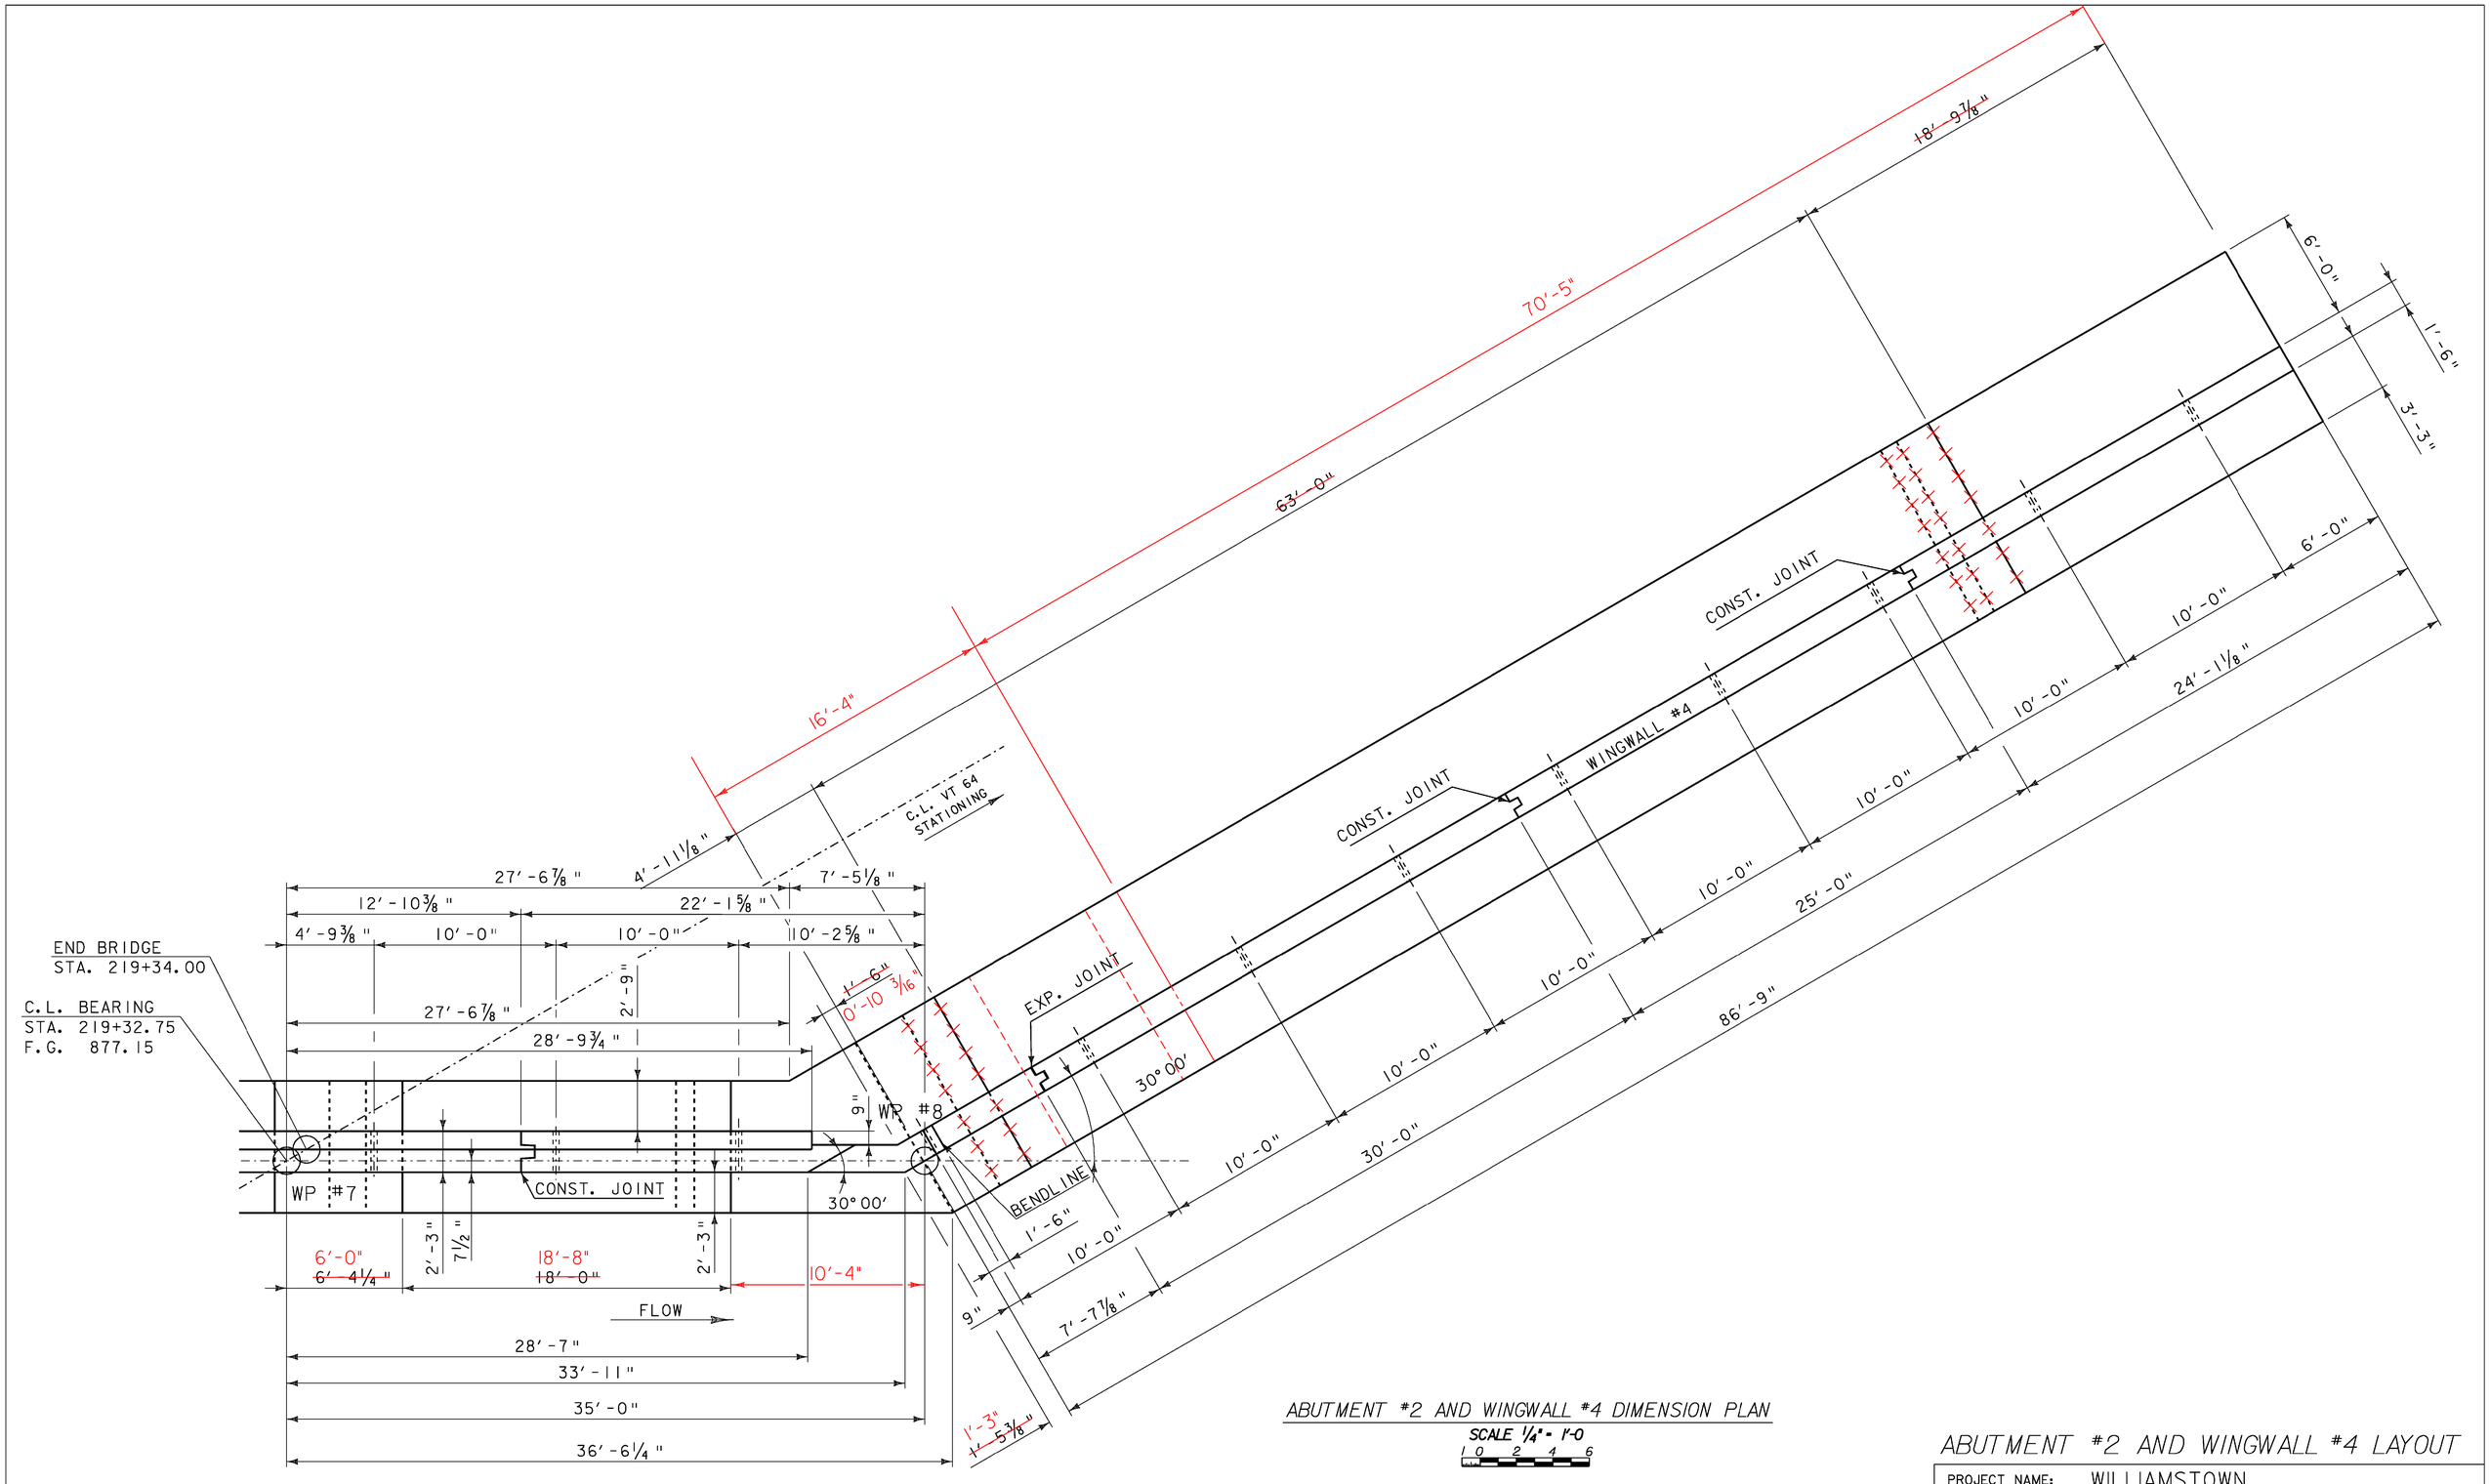

ABUTMENT #2 AND WINGWALL #4 DIMENSION PLAN

SCALE 1/4" = 1'-0

ABUTMENT #2 AND WINGWALL #4 LAYOUT

PROJECT NAME:	WILLIAMSTOWN
PROJECT NUMBER:	BRS 0204(4)

FILE NAME: 83ell\str\sellabut2.dgn	PLOT DATE: 07-APR-2008
PROJECT LEADER: M.EVANS-MONGEON	DRAWN BY: EVANS-MONGEON
DESIGNED BY: M.EVANS-MONGEON	CHECKED BY: U. STANLEY
IPARM sellsub4.I	SHEET 56 OF 108