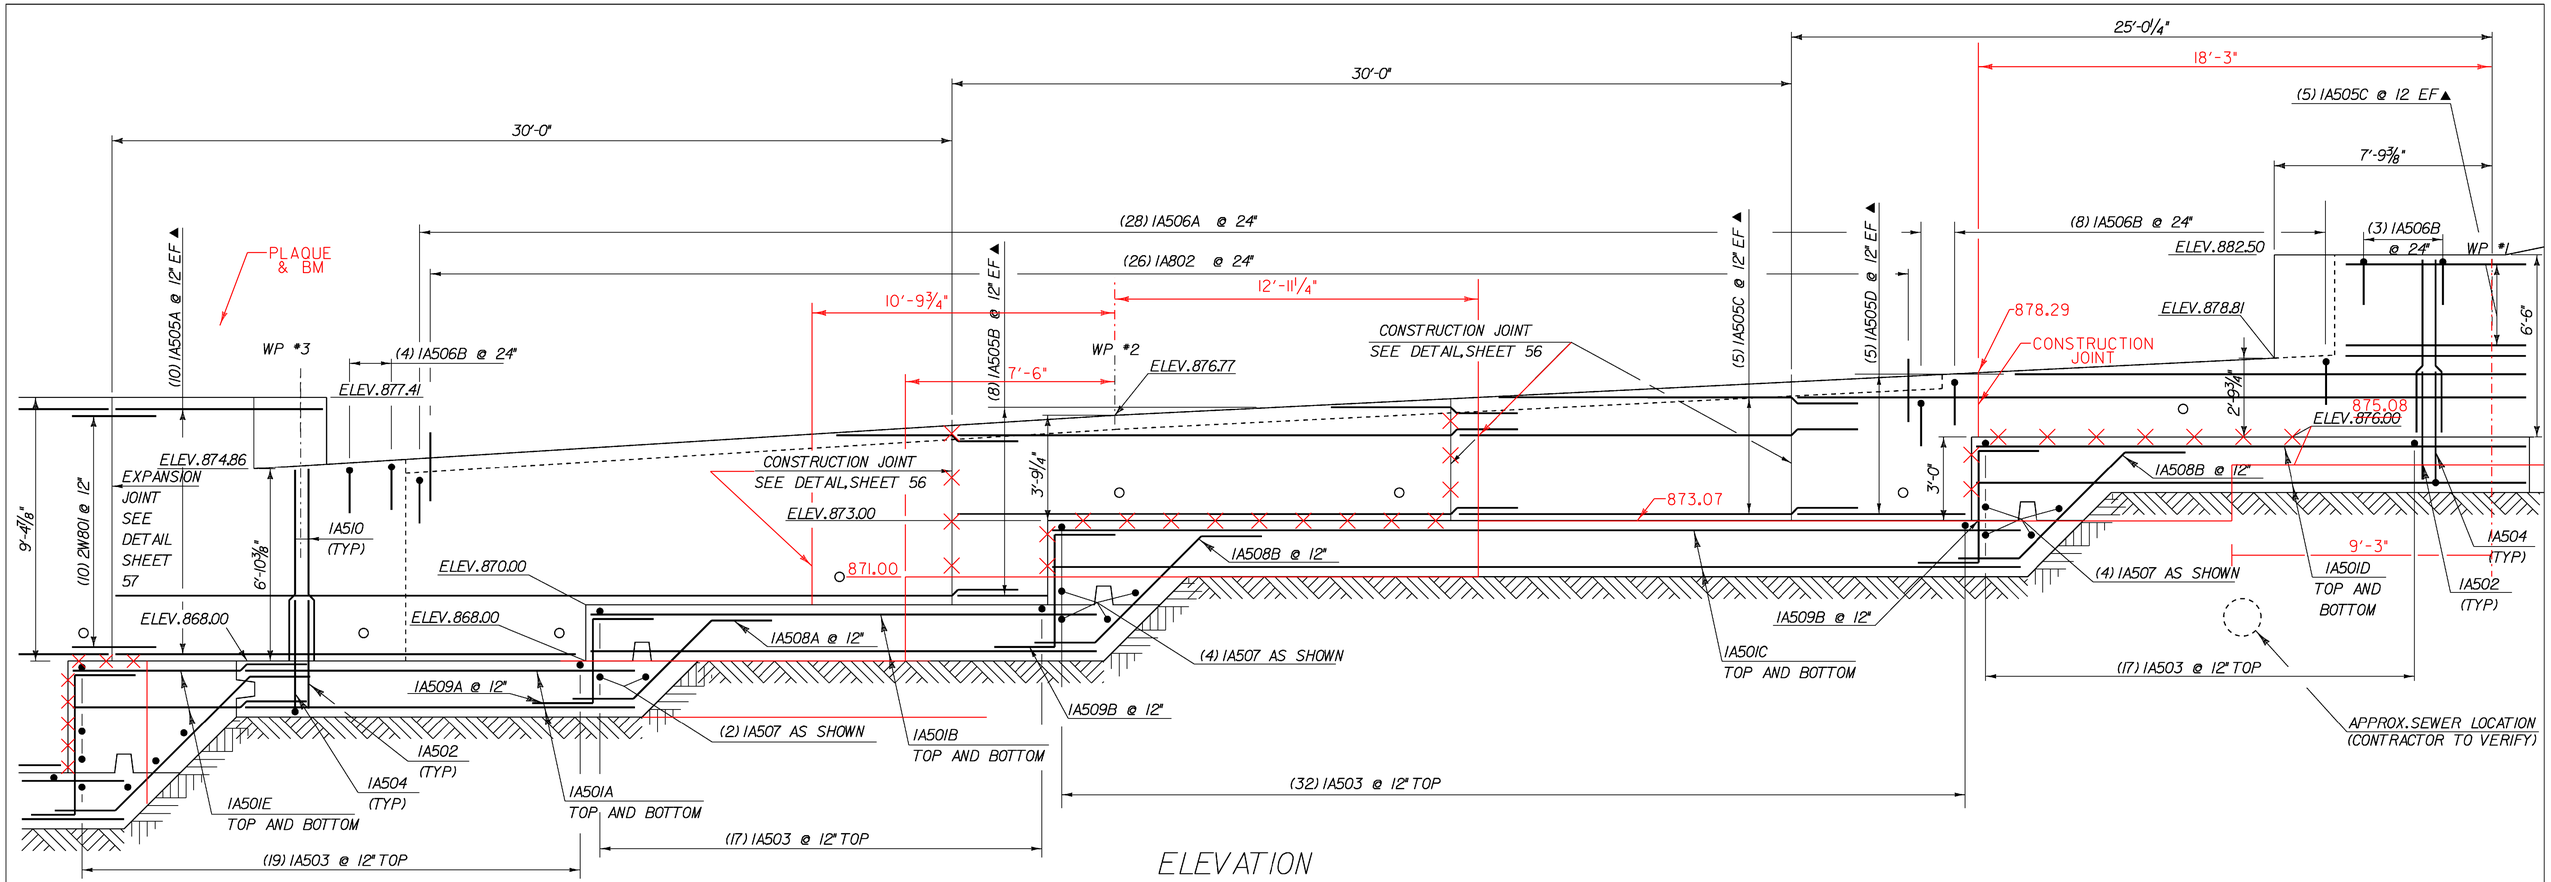

ELEVATION

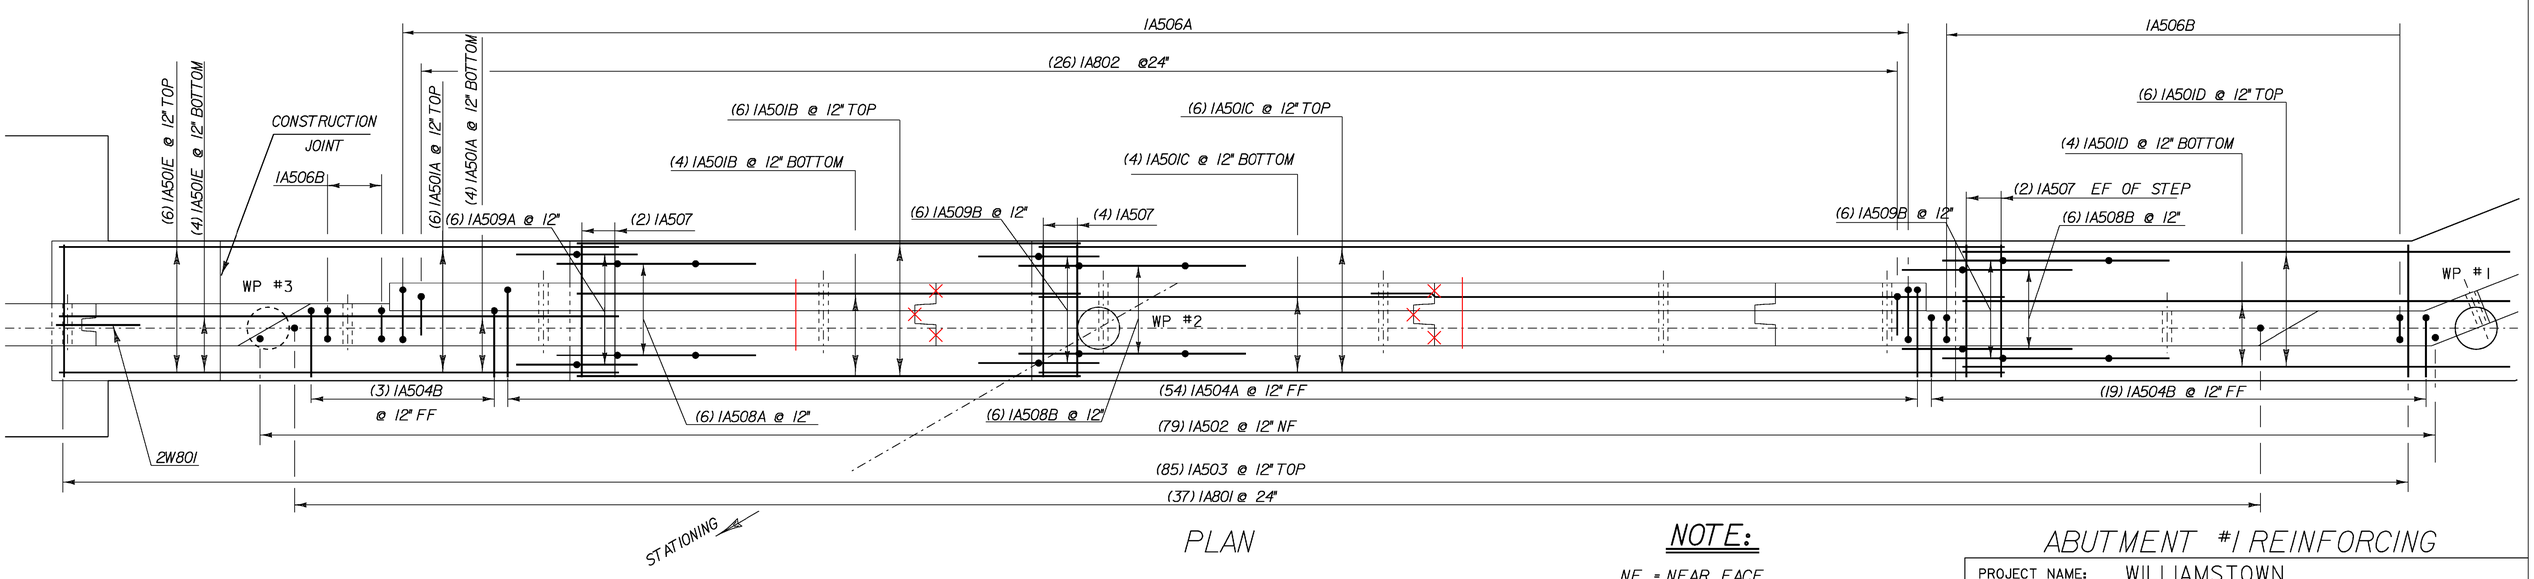

PLAN

ABUTMENT #1

SCALE 3/8" = 1'-0

1 0 1 2 3 4

NOTE:

NF = NEAR FACE
FF = FAR FACE
EF = EACH FACE
▲ = CUT TO FIT IN FIELD
3" CLR. UNLESS OTHERWISE SPECIFIED ON THE PLANS.

ABUTMENT #1 REINFORCING

PROJECT NAME:	WILLIAMSTOWN
PROJECT NUMBER:	BRS 0204(4)

FILE NAME: 83ellI\str.\ellabutI.dg	PLOT DATE: 07-APR-2008
PROJECT LEADER: M.EVANS.MONGEON	DRAWN BY: G.ROKES
DESIGNED BY: M.EVANS-MONGEON	CHECKED BY: U. STANLEY
IPARM ellsub6.I	SHEET 58 OF 108