STATE OF VERMONT
AGENCY OF TRANSPORTATION

TRAFFIC SIGN SUMMARY SHEET

Metric

KILOMETER MARKER, STATION, OR SIGN NUMBER	SIGN LEGEND	SIGN DIMENSIONS EA	WIDTH (mm)	HEIGHT (mm)	NEW & SALVAGED SIGNS "A"	"B"	SALV SIGN	SALV TIS	EXIST POST RETAIN	SALVAGE	NO. OF POSTS	NEW SIGN POSTS: FLANGED CHANNEL kg/m 1.7	3.0	4.5	SQUARE STEEL (mm) kg/m 44 / 3.4	50 / 3.9	63 / 5.0	ANCHOR	SLIPFITTER	TUBULAR ALUMINUM Ø (mm) kg/m 75 / 1.9	100 / 2.5	100 MOD. / 2.5	FOUND-ATION	TUBULAR STEEL Ø (mm) kg/m 75 / 11.3	89 / 13.4	100 / 16.1	125 / 21.7	W-SHAPE STEEL FTG. SIZE 600 mm	750 mm	WEIGHT	POST SIZE	SIGN FACE REQUIRED	REMARKS	SIGN DETAIL: DETAIL ON SHEET NUMBER	STD. SHEET NUMBER
														OPTION ITEMS																						
STA 10+020 LT	STOP	1	750	750	0.56						1			X 4.02																			RI-1		E-143
STA 10+030 RT	LEGAL LOAD LIMIT 24,000 POUNDS	1	600	750	0.45						1			X 3.94																			VR-017		E-141
STA 10+082 LT		1	900	900	0.81						2			X 4.07																			W3-1A		E-150
STA 0+758 LT	STOP	1	750	750	0.56						1			X 3.90																			RI-1		E-143
STA 0+758 LT	CHURCH STREET	1	940	230	0.22																												SEE DETAIL BELOW		
STA 0+768 LT	LEGAL LOAD LIMIT 24,000 POUNDS	1	600	750	0.45						1			X 3.92																			VR-017		E-141
STA 0+769 LT		1	1200	600	0.72						2			X 8.68																			WI-6		E-152
STA 0+771RT	BRIDGE 1 VT 346	1	150	200	0.03						1		X	2.57																			VD-701		E-134
STA 0+781LT	BRIDGE 1 VT 346	1	150	200	0.03						1		X	2.63																			VD-701		E-134

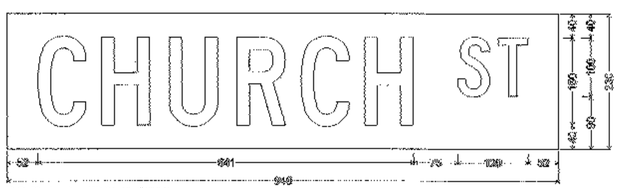

D-3; 1½ border, White on Green;
"CHURCH" C; "ST" C; 6mm spacing;

FINAL POST ARE TO BE DETERMINED IN THE FIELD. POST SIZES ARE COMPUTED BASED ON INFORMATION FURNISHED ON THE STANDARD SHEETS AND THE TRAFFIC & SAFETY DIVISION'S "SIGN POST DESIGN GUIDELINE."

												m	m 0 ~~3.6~~	m 33.73 ~~32.4~~	m	m	m		EA.	kg	kg	kg		kg	kg	kg	kg								
TOTALS		m^2 3.83	m^2	EA.	m^2							m ~~36.0~~ 33.73			m					kg			EA.		kg			EA.	EA.	kg					

TRAFFIC SIGN SUMMARY

PROJECT NAME: POWNAL
PROJECT NUMBER: STP RS 0107(8)

FILE NAME: /84c028/str/sc028sgn.dgn
PROJECT LEADER: W. SYMONDS
DESIGNED BY: G. SHANGRAW
sc028sgl.l

PLOT DATE: 10-MAY-2007
DRAWN BY: G. SHANGRAW
CHECKED BY: T. FILLBACH
SHEET 50 OF 65