TRAFFIC SIGN AND PAVEMENT MARKING SHEET

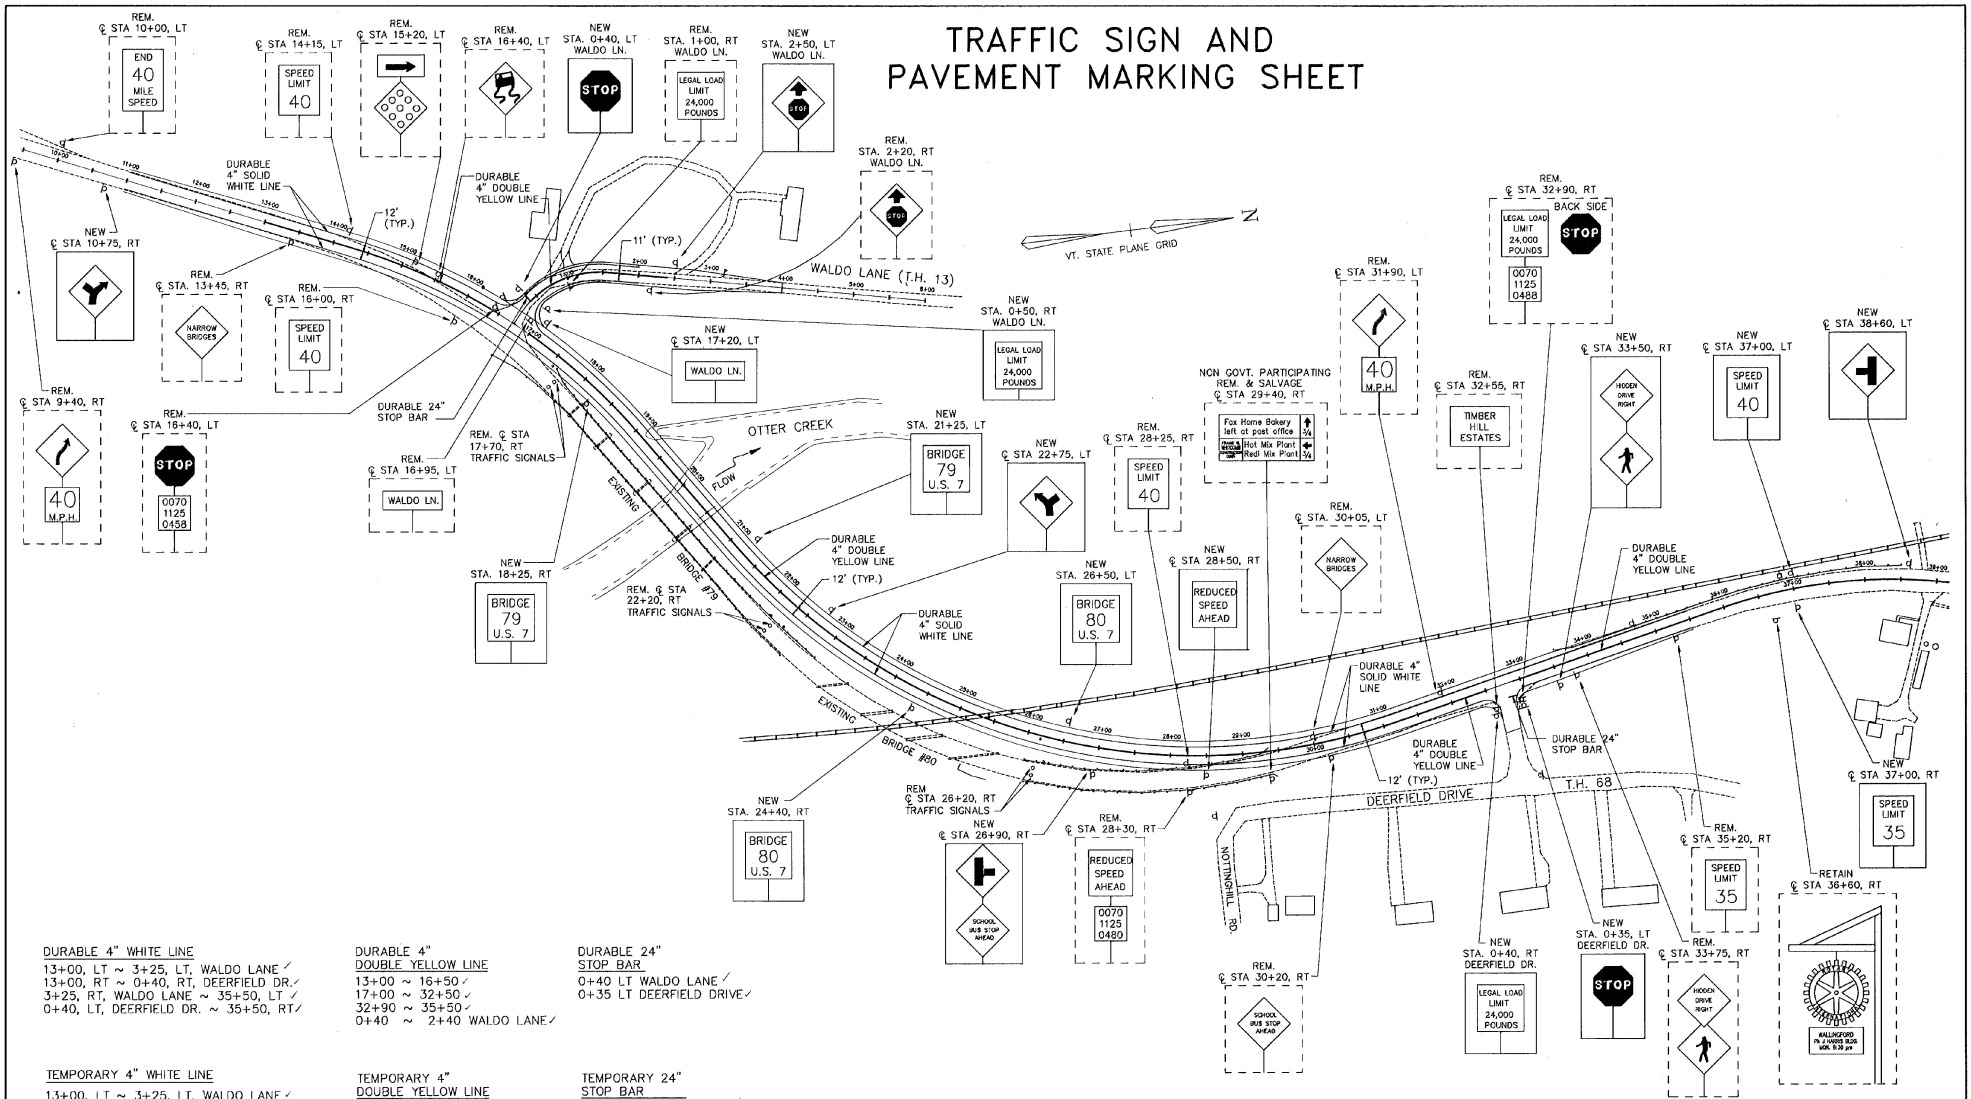

DURABLE 4" WHITE LINE

13+00, LT ~ 3+25, LT, WALDO LANE ✓
13+00, RT ~ 0+40, RT, DEERFIELD DR. ✓
3+25, RT, WALDO LANE ~ 35+50, LT ✓
0+40, LT, DEERFIELD DR. ~ 35+50, RT ✓

DURABLE 4" DOUBLE YELLOW LINE

13+00 ~ 16+50 ✓
17+00 ~ 32+50 ✓
32+90 ~ 35+50 ✓
0+40 ~ 2+40 WALDO LANE ✓

DURABLE 24" STOP BAR

0+40 LT WALDO LANE ✓
0+35 LT DEERFIELD DRIVE ✓

TEMPORARY 4" WHITE LINE

13+00, LT ~ 3+25, LT, WALDO LANE ✓
13+00, RT ~ 0+40, RT, DEERFIELD DR. ✓
3+25, RT, WALDO LANE ~ 35+50, LT ✓
0+40, LT, DEERFIELD DR. ~ 35+50, RT ✓

TEMPORARY 4" DOUBLE YELLOW LINE

13+00 ~ 16+50 ✓
17+00 ~ 32+50 ✓
32+90 ~ 35+50 ✓
0+40 ~ 2+40 WALDO LANE ✓

TEMPORARY 24" STOP BAR

0+40, LT WALDO LANE ✓
0+35, LT DEERFIELD DRIVE ✓

SURVEYED BY	VSC	DATE	10/91
DRAWN BY	FJC	DATE	11/94
TRACED BY	SAS	DATE	11/94

WALLINGFORD

PROJ. BRS NO. 0137(13)
SHEET 20 OF 113 SHEETS

D:\CIVIL\WALLY\91120-20.DWG (1=80)