| FED. ROAD DIV. NO. | STATE | FED. AID PROJ. NO. |
|---|---|---|
| | VT | |

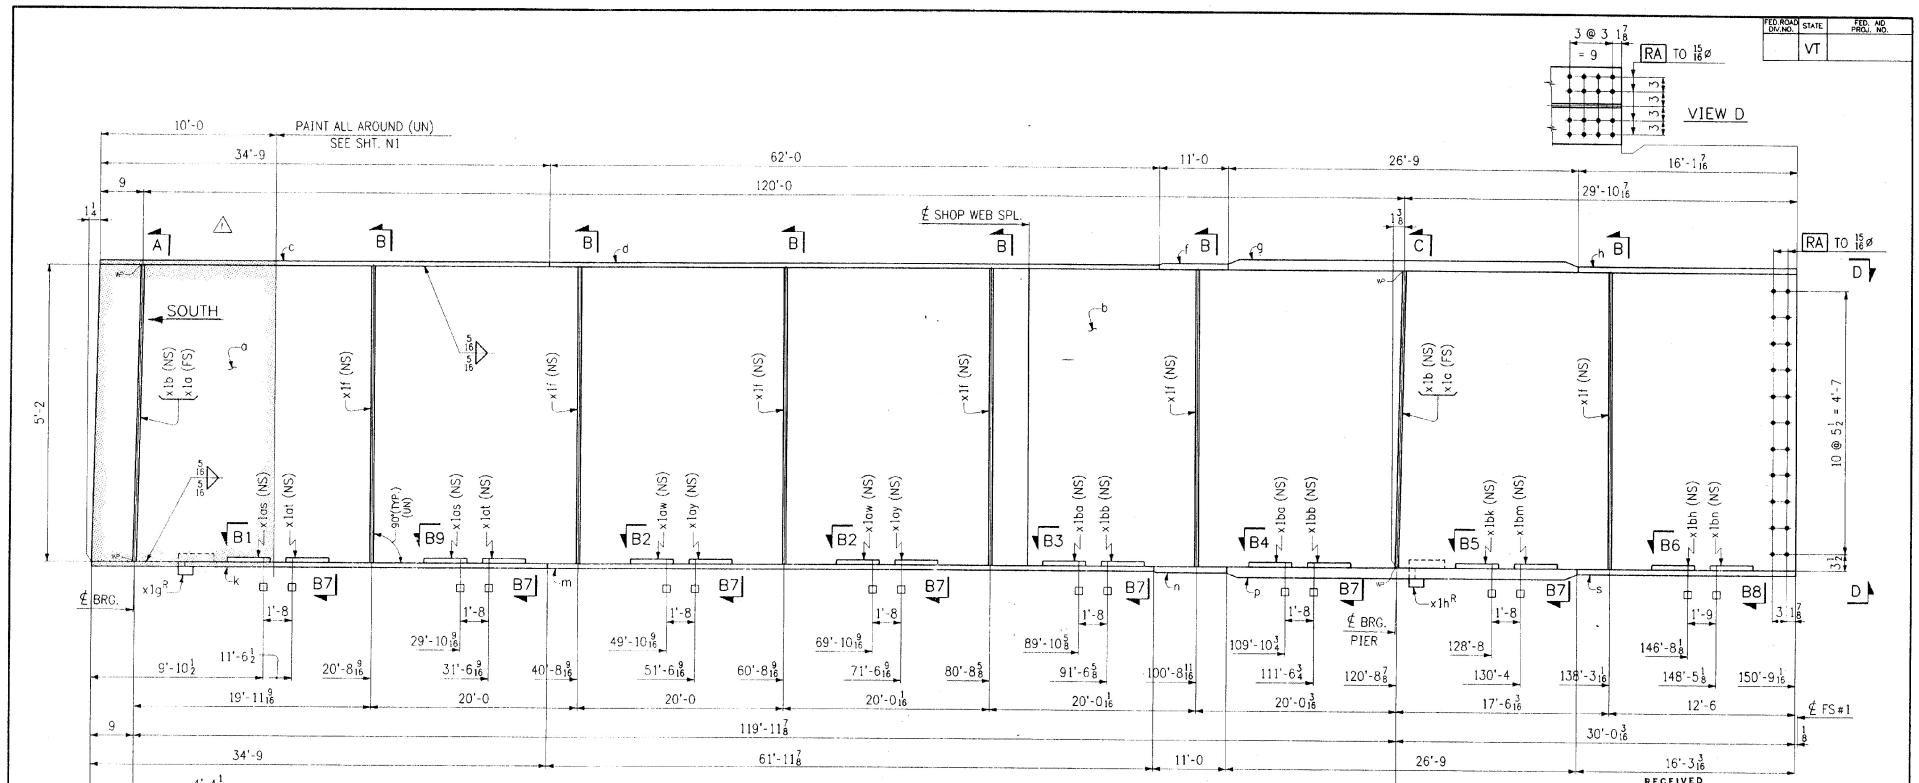


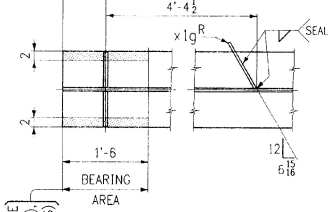


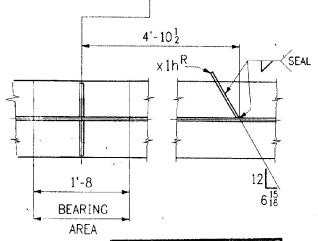


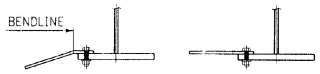


PAINT LIGHT RUST PREVENTIVE COAT OF PRIMER (FS), EDGES & SHADED AREA (NS)

WORK THIS DWG. WITH DWG. 6

RECEIVED
CK'D BY ____ CK'D BY ____
MAY 27 1996
RESUBMIT ____ APPROVED ____
BY ____ DATE ____

**SHOP DRAWING REVIEW**
REVIEW IS FOR GENERAL COMPLIANCE WITH CONTRACT DOCUMENTS. NO RESPONSIBILITY IS ASSUMED FOR CORRECTNESS OF DIMENSIONS OR DETAILS.
APPROVED
APPROVED AS NOTED
AMEND AND RESUBMIT
REJECTED (SEE SUMMARY)
Barnes and Jarnis, Inc.
80 Hopkinton Street
Ashland, Massachusetts 01721
DATE 6/13/96 BY EMW

| NO. | REVISION | DATE |
|---|---|---|
| △ | | |
| △ | | |
| 1 | DELETED SECT. P : DESIGN CHANGE | 5-20-96 |

HIGH STEEL STRUCTURES, INC.
1770 Hempstead Road
Lancaster, PA 17605-0008
Phone 717/299-5211
A Division of High Industries, Inc.

GIRDER G1A
U.S. ROUTE 7 OVER OTTER CREEK
BRIDGE NO. 79
TOWN OF WALLINGFORD, COUNTY OF RUTLAND
STATE OF VERMONT
AGENCY OF TRANSPORTATION

STATE CONTRACT OR REF. NO. PROJECT NO. BRS-0137(13)
MAY 1 1995
CONTRACTOR J. A. McDONALD, INC.
IN CHARGE: abs MADE BY: PPP (-31) CHK'D BY: LD DATE: 2-2-96
CONTRACT NUMBER: VT-95367 DRAWING NUMBER: 5 OF 24
CODE: 30

402-9