| FED. ROAD DIV. NO. | STATE | FED. AID PROJ. NO. |
|---|---|---|
| | VT | |

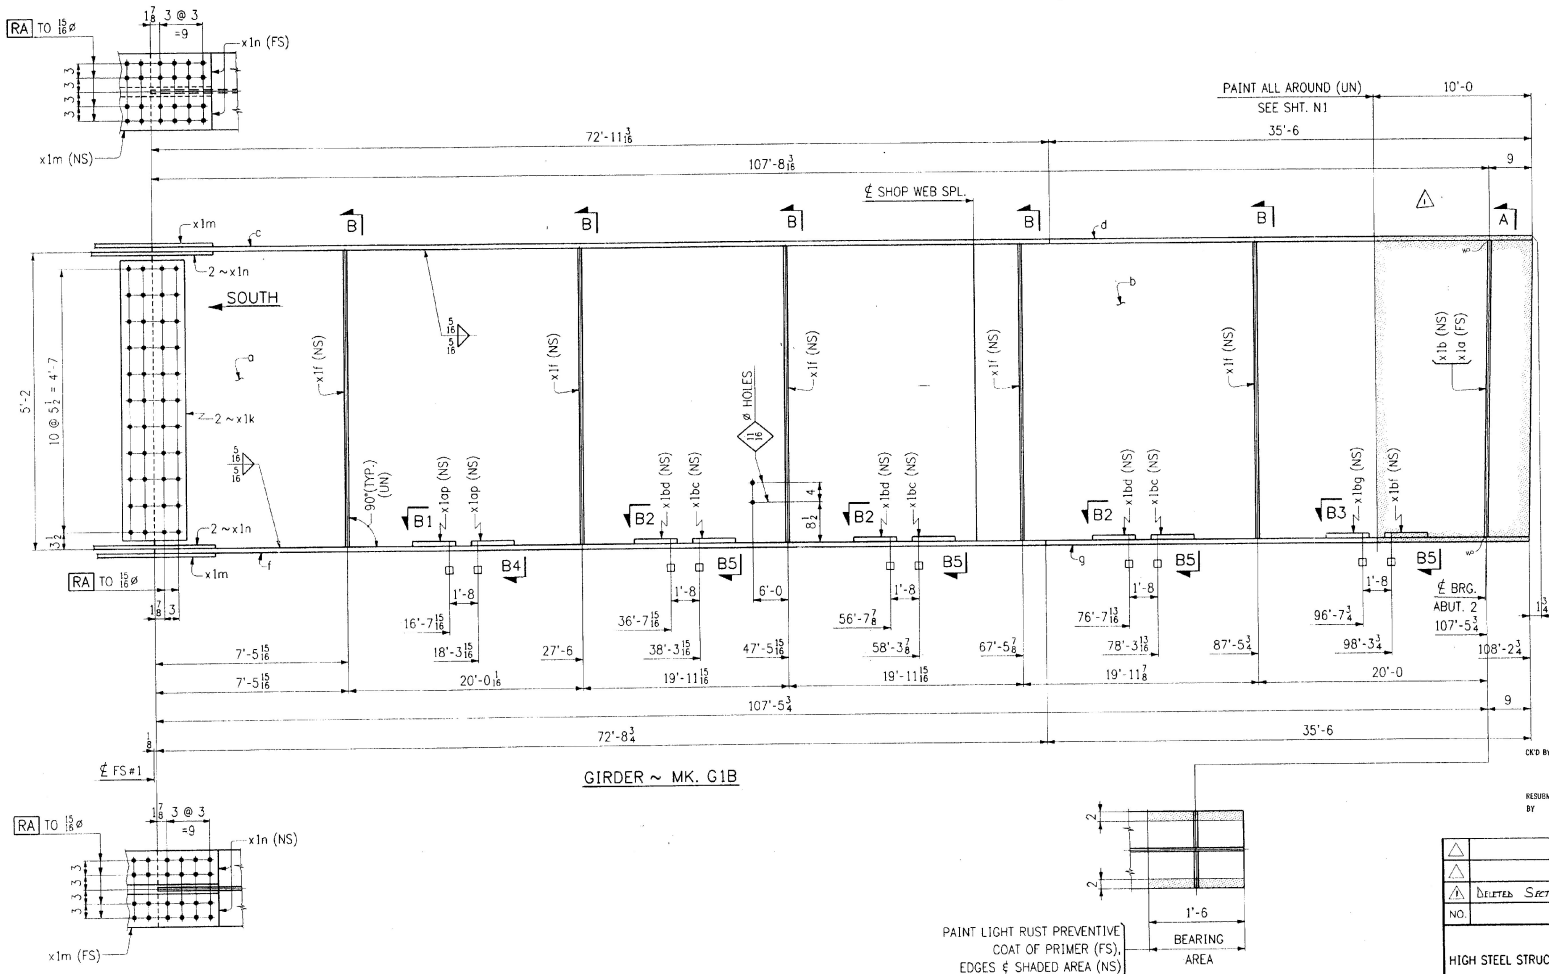


GIRDER ~ MK. G1B




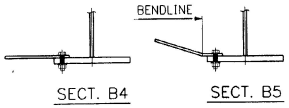


SHOP DRAWING REVIEW
REVIEW IS FOR GENERAL CONFORMANCE WITH CONTRACT DOCS. WITH NO RESPONSIBILITY IN ACCURACY OF DIMENSIONS OR DETAILS.
APPROVED
APPROVED AS NOTED
AMEND AND RESUBMIT
REJECTED - SEE REMARKS
Barnes and Jarvis, Inc.
6 Boynton Street
Worcester, Massachusetts 02119
DATE 6/10/96 BY EMM

WORK THIS DWG. WITH DWG. 16

CODE: 30

RECEIVED
CK'D BY _____ CK'D BY _____
MAY 27 1996
RESUBMIT _____ APPROVED _____
BY DATE

| NO. | REVISION | DATE |
|---|---|---|
| 1 | DELETED SECT. P : DESIGN CHANGE | 5-20-96 |

HIGH STEEL STRUCTURES, INC.
1770 Hempstead Road
Lancaster, PA 17601-0008
Phone 717/299-5211
A Division of High Industries, Inc.

GIRDER G1B
U.S. ROUTE 7 OVER OTTER CREEK
BRIDGE NO. 79
TOWN OF WALLINGFORD, COUNTY OF RUTLAND
STATE OF VERMONT
AGENCY OF TRANSPORTATION

STATE CONTRACT OR REF. NO. PROJECT NO. BRS-0137(13)
MAY 21 1996
CONTRACTOR J. A. McDONALD, INC.
IN CHARGE: abs MADE BY: PPF 2-2 CHK'D BY: LD DATE: 2-3-96
CONTRACT NUMBER: VT-95367 DRAWING NUMBER: 15 OF 24

400-9

G1B-400