FED. ROAD DIV. NO.	STATE	FED. AID PROJ. NO.
	VT	

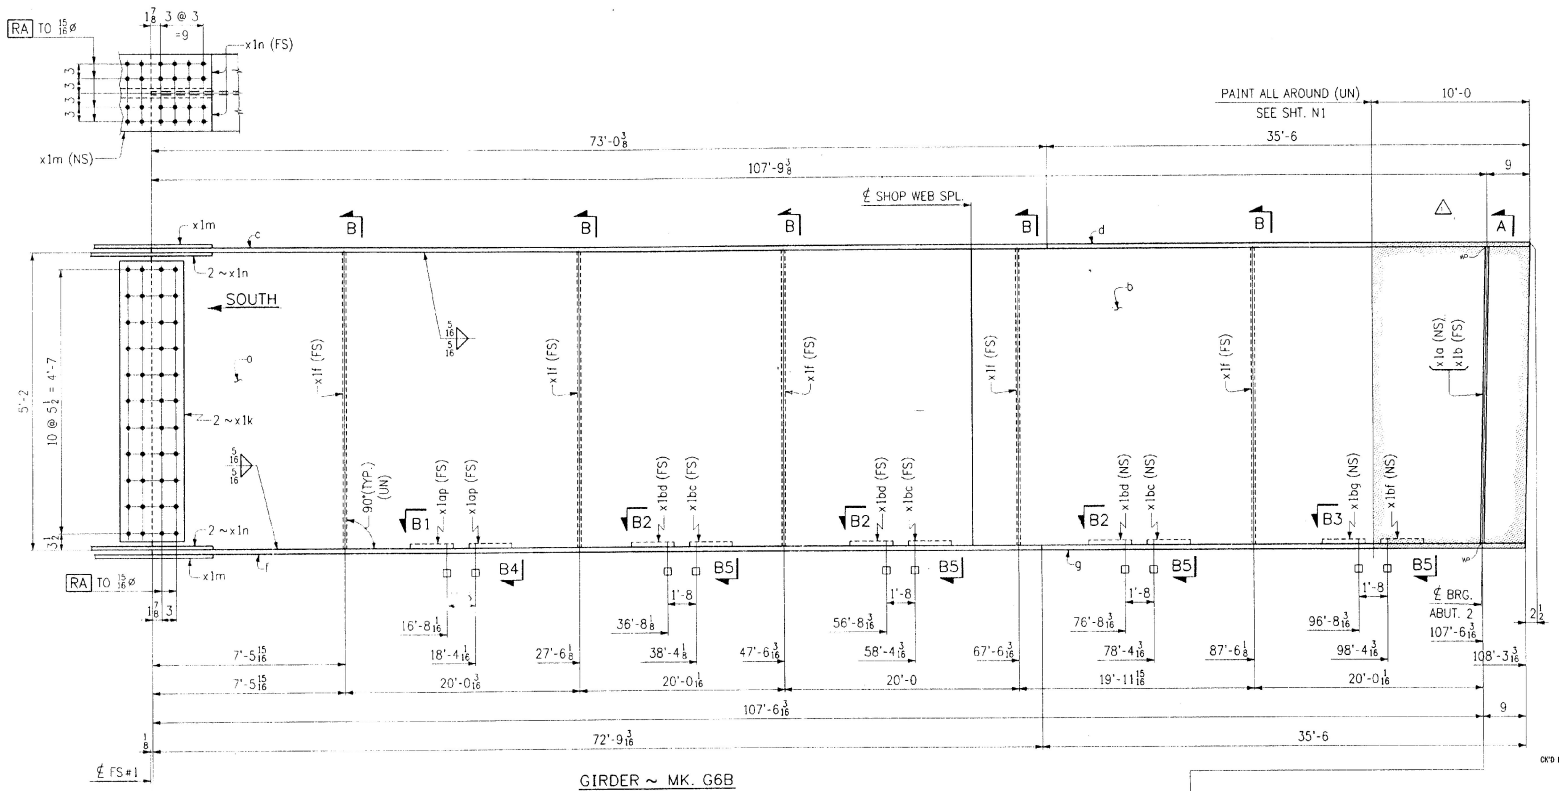

GIRDER ~ MK. G6B

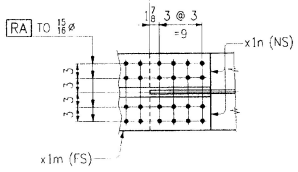

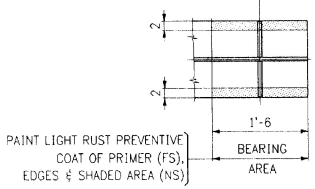

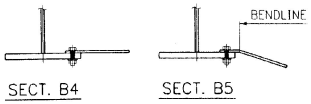

SECT. B4 SECT. B5

SHOP DRAWING REVIEW
REVIEW IS FOR GENERAL COMPLIANCE WITH CONTRACT DOCUMENTS. NO RESPONSIBILITY IS ASSUMED FOR CORRECTNESS OF DIMENSIONS OR DETAILS.
APPROVED
APPROVED AS NOTED
AMEND AND RESUBMIT
REJECTED AND REMARKS
Barnes and Jarnis, Inc.
50 Roulston Street
Fairfield, Connecticut 06430
DATE 6/24/96 BY EMH

WORK THIS DWG. WITH DWG. 24

CODE: 30

RECEIVED
CK'D BY_____ DK'D BY_____
MAY 27 1996
RESUBMIT_____ APPROVED_____
BY DATE

NO.	REVISION	DATE
△		
△		
△	DELETED SECT. P: DESIGN CHANGE	5-20-96

HIGH STEEL STRUCTURES, INC.
1770 Hempstead Road
Lancaster, PA 17605-0008
Phone (717) 299-5211
A Division of High Industries, Inc.

GIRDER G6B
U.S. ROUTE 7 OVER OTTER CREEK
BRIDGE NO. 79
TOWN OF WALLINGFORD, COUNTY OF RUTLAND
STATE OF VERMONT
AGENCY OF TRANSPORTATION

STATE CONTRACT OR REF. NO. PROJECT NO. BRS-0137(13) MAY 21 1996
CONTRACTOR J. A. McDONALD, INC.
IN CHARGE: abs MADE BY: PPP 2-3 CHK'D BY: LD DATE: 2-5-96
CONTRACT NUMBER: VT-95367 DRAWING NUMBER: 23 OF 24

400-9 G6B-400