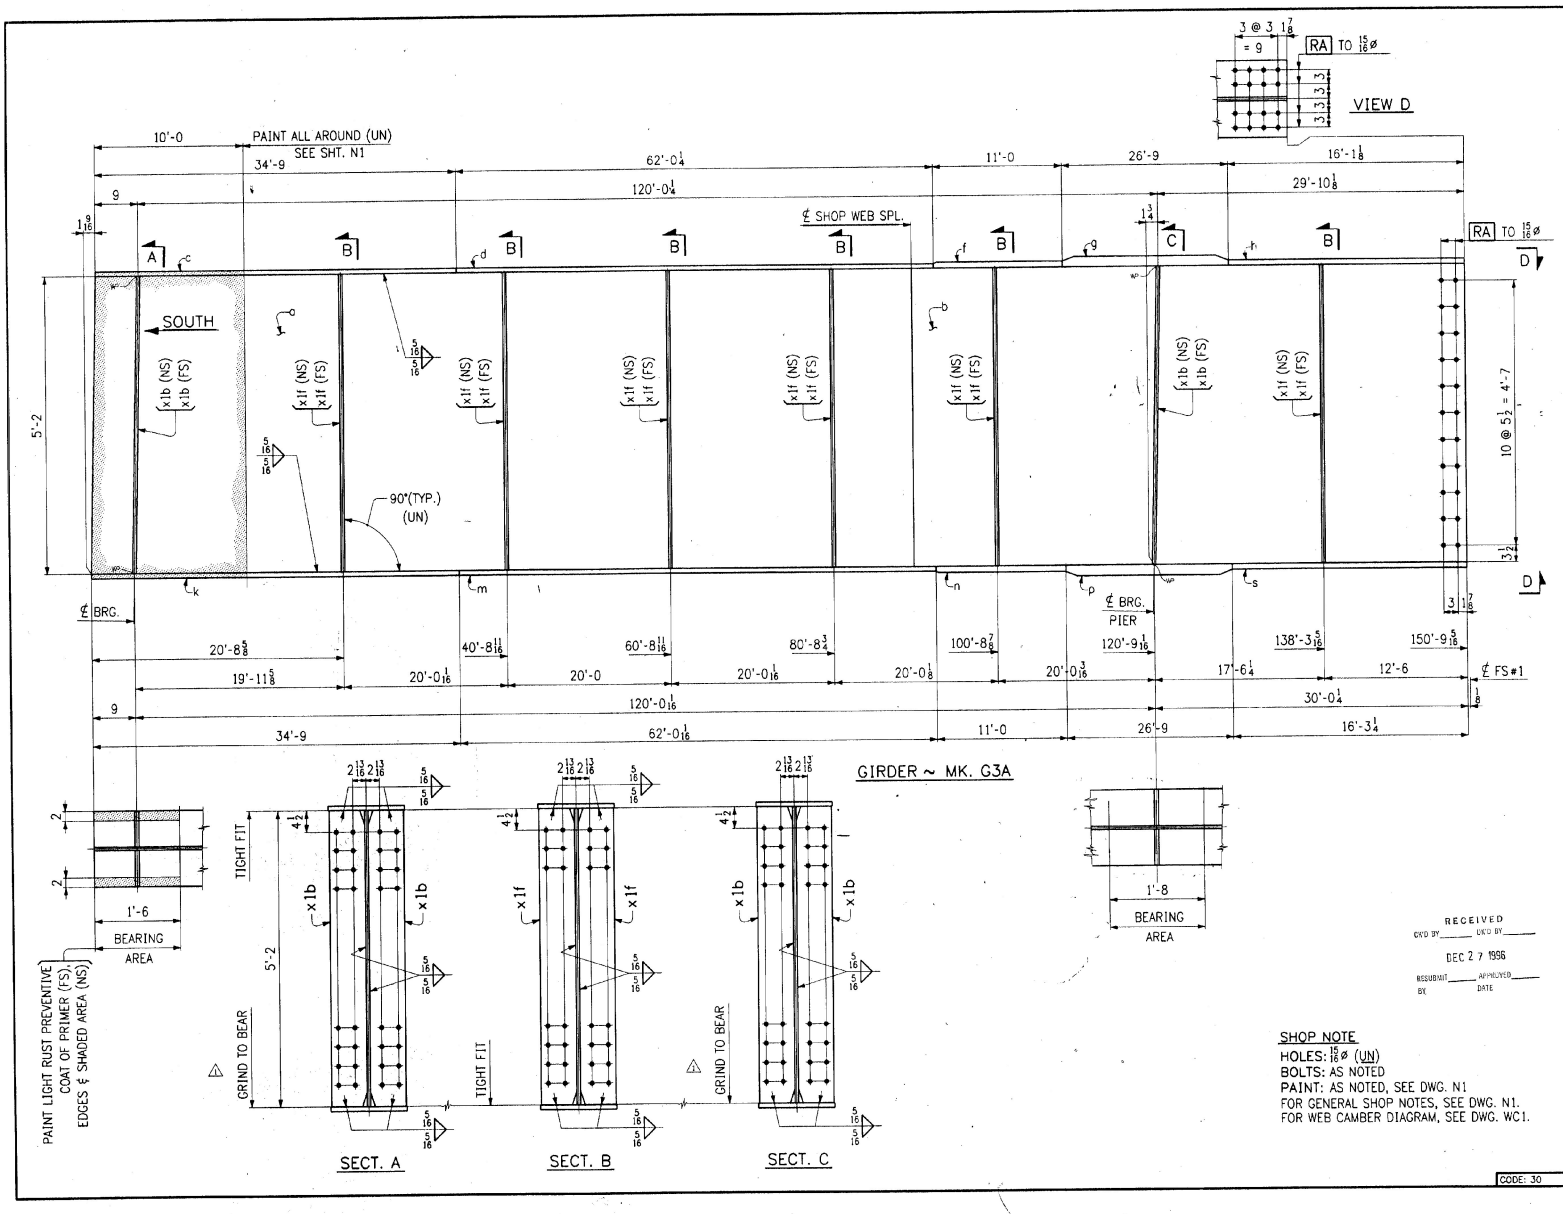

FED. ROAD DIV. NO.	STATE	FED. AID PROJ. NO.
	VT	

BILL OF MATERIAL

NO.	MARK	DESCRIPTION	LENGTH		REMARKS	ITEM	SHIP WEIGHT
ONE	G3A	GIRDER					
1	a	PL 62 x 5/8	88	9	(T)	2/3	1951.57
1	b	PL 62 x 5/8	62	0 5/16	(T)	2/2	1070.41
1	c	PL 16 x 15/16	34	9	(T)	2/18	1773.70
1	d	PL 16 x 15/16	62	0 1/4	(T)	2/17	3141.42
1	f	PL 16 x 1 1/4	11	0	(T)	2/11	748.41
1	g	PL 16 x 2 3/16	26	9	(T)	2/9	2480.85
1	h	PL 16 x 1 1/8	16	1 1/8	(T)	2/15	865.78
1	k	PL 16 x 15/16	34	9	(T)	2/18	1773.70
1	m	PL 16 x 15/16	62	0 1/16	(T)	2/17	3141.65
1	n	PL 16 x 1 1/4	11	0	(T)	2/11	748.41
1	p	PL 16 x 2 3/16	26	9	(T)	2/9	2480.85
1	s	PL 16 x 1 1/8	16	3 1/4	(T)	2/15	896.59
4	x1b	BAR 7 1/2 x 7/8	5	2		3/12	125.38
12	x1f	BAR 7 1/2 x 1/2	5	2		3/14	85.93

TOTAL WEIGHT THIS DWG
ITEM 506.55 = 40,862.81

RECEIVED
CK'D BY ____ CK'D BY ____
DEC 27 1996
RESUBMIT ____ APPROVED ____
BY: DATE

SHOP NOTE
HOLES: 15/16ø (UN)
BOLTS: AS NOTED
PAINT: AS NOTED, SEE DWG. N1
FOR GENERAL SHOP NOTES, SEE DWG. N1.
FOR WEB CAMBER DIAGRAM, SEE DWG. WC1.

NO.	REVISION	DATE
1	CHANGED "MILL" TO "GRIND"	2-21-96

HIGH STEEL STRUCTURES, INC.
1770 Hempstead Road
Lancaster, Pa 17605-0008
Phone 717/299-5211
A Division of High Industries, Inc.

GIRDER G3A
U.S. ROUTE 7 OVER OTTER CREEK
BRIDGE NO. 79
TOWN OF WALLINGFORD, COUNTY OF RUTLAND
STATE OF VERMONT
AGENCY OF TRANSPORTATION

STATE CONTRACT OR REF. NO. PROJECT NO. BRS-0137(13)
CONTRACTOR J. A. McDONALD, INC.
IN CHARGE: abs MADE BY: PPP 2-1 CHK'D BY: LD DATE: 2-2-96
CONTRACT NUMBER: VT-95367 DRAWING NUMBER: 9 OF 24

CODE: 30

400-9

G3A-400

DEC1 91996