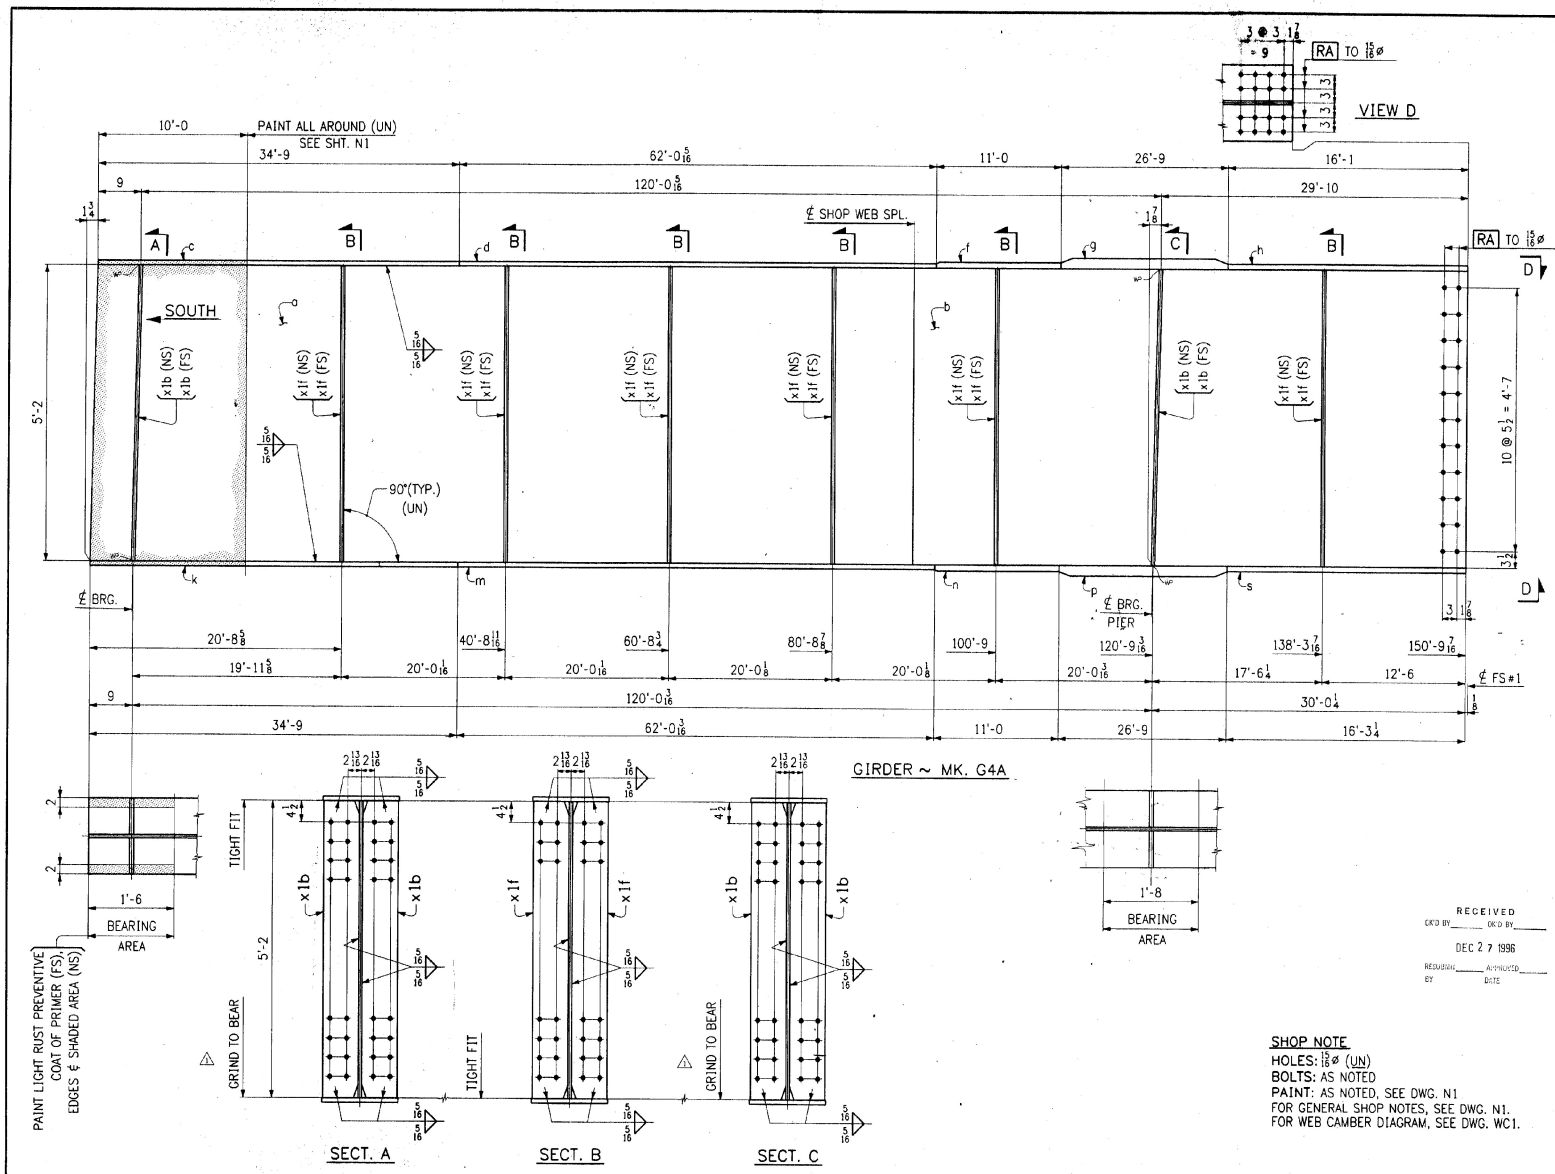

FED. ROAD DIV. NO.	STATE	FED. AID PROJ. NO.
	VT	

BILL OF MATERIAL

NO.	MARK	DESCRIPTION	LENGTH		REMARKS	ITEM	WEIGHT EACH
ONE	G4A	GIRDER					
1	a	PL 62 x 5/8	88	9	(T)	2 3	1202.97
1	b	PL 62 x 5/8	62	0 7/16	(T)	2 2	847.98
1	c	PL 16 x 15/16	34	9	(T)	2 18	133.10
1	d	PL 16 x 15/16	62	0 5/16	(T)	2 17	242.97
1	f	PL 16 x 1 1/4	11	0	(T)	2 11	148.41
1	g	PL 16 x 2 3/16	26	9	(T)	2 9	485.85
1	h	PL 16 x 1 1/8	16	1	(T)	2 15	185.10
1	k	PL 16 x 15/16	34	9	(T)	2 18	133.10
1	m	PL 16 x 15/16	62	0 5/16	(T)	2 17	242.97
1	n	PL 16 x 1 1/4	11	0	(T)	2 11	148.41
1	p	PL 16 x 2 3/16	26	9	(T)	2 9	485.85
1	s	PL 16 x 1 1/8	16	3 1/4	(T)	2 15	196.59
4	x1b	BAR 7 1/2 x 7/8	5	2		3 12	15.38
12	x1f	BAR 7 1/2 x 1/2	5	2		3 14	5.48

TOTAL WEIGHT THIS DWG.
ITEM 506.55 = 40,364.35#

NO.	REVISION	DATE
1	CHANGED "MILL" TO "GRIND"	2-21-96

RECEIVED
CK'D BY ____ CK'D BY ____
DEC 2 7 1996
REQUISITION ____ AUTHORIZED ____
BY DATE

SHOP NOTE
HOLES: 15/16 Ø (UN)
BOLTS: AS NOTED
PAINT: AS NOTED, SEE DWG. N1
FOR GENERAL SHOP NOTES, SEE DWG. N1.
FOR WEB CAMBER DIAGRAM, SEE DWG. WC1.

CODE: 30

HIGH STEEL STRUCTURES, INC.
1770 Hempstead Road
Lancaster, PA 17605-0008
Phone 717/299-5211
A Division of High Industries, Inc.

GIRDER G4A
U.S. ROUTE 7 OVER OTTER CREEK
BRIDGE NO. 79
TOWN OF WALLINGFORD, COUNTY OF RUTLAND
STATE OF VERMONT
AGENCY OF TRANSPORTATION

STATE CONTRACT OR REF. NO. PROJECT NO. BRS-0137(13)
CONTRACTOR J. A. McDONALD, INC.
IN CHARGE: abs MADE BY: PPP CHK'D BY: LD DATE: 2-2-96
CONTRACT NUMBER: VT-95367 DRAWING NUMBER: 10 OF 24

400-9