FED. ROAD DIV. NO.	STATE	FED. AID PROJ. NO.
	VT	

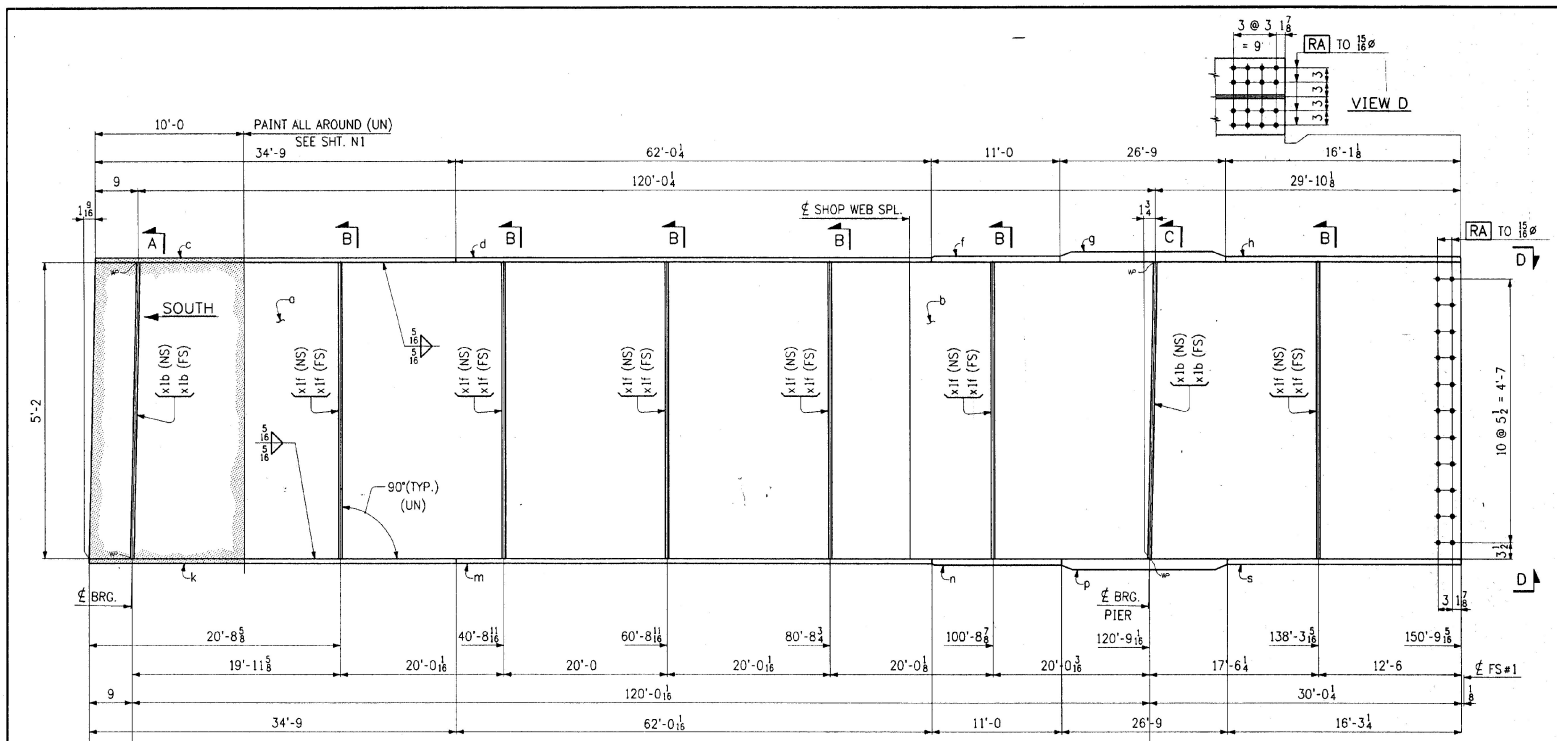

GIRDER ~ MK. G3A

BILL OF MATERIAL

NO.	MARK	DESCRIPTION	LENGTH		REMARKS	ITEM	SHIP WEIGHT EA.
ONE	G3A	GIRDER					40865
1	a	PL 62 x 5/8	88	9	(T)	2/3	
1	b	PL 62 x 5/8	62	0 3/16	(T)	2/2	
1	c	PL 16 x 15/16	34	9	(T)	2/18	
1	d	PL 16 x 15/16	62	0 1/4	(T)	2/17	
1	f	PL 16 x 1 1/4	11	0	(T)	2/11	
1	g	PL 16 x 2 13/16	26	9	(T)	2/9	
1	h	PL 16 x 1 1/8	16	1 1/8	(T)	2/15	
1	k	PL 16 x 15/16	34	9	(T)	2/18	
1	m	PL 16 x 15/16	62	0 1/16	(T)	2/17	
1	n	PL 16 x 1 1/4	11	0	(T)	2/11	
1	p	PL 16 x 2 13/16	26	9	(T)	2/9	
1	s	PL 16 x 1 1/8	16	3 1/4	(T)	2/15	
4	x1b	BAR 7 1/2 x 7/8	5	2		3/12	
12	x1f	BAR 7 1/2 x 1/2	5	2		3/14	

SHOP NOTE
HOLES: 15/16ø (UN)
BOLTS: AS NOTED
PAINT: AS NOTED, SEE DWG. N1
FOR GENERAL SHOP NOTES, SEE DWG. N1.
FOR WEB CAMBER DIAGRAM, SEE DWG. WC1.

SHOP DRAWING REVIEW
REVIEW IS FOR GENERAL COMPLIANCE WITH CONTRACT DOCUMENTS. NO RESPONSIBILITY IS ASSUMED FOR CORRECTNESS OF DIMENSIONS OR DETAILS.
APPROVED
APPROVED AS NOTED
AMEND AND RESUBMIT
REJECTED - SEE REMARKS
Barnes and Jarnis, Inc.
MAR 22 1996

NO.	REVISION	DATE
1	CHANGED "MILL" TO "GRIND"	2-21-96

HIGH STEEL STRUCTURES, INC.
1770 Hempstead Road
Lancaster, PA 17605-0008
Phone 717/299-5211
A Division of High Industries, Inc.

GIRDER G3A
U.S. ROUTE 7 OVER OTTER CREEK
BRIDGE NO. 79
TOWN OF WALLINGFORD, COUNTY OF RUTLAND
STATE OF VERMONT
AGENCY OF TRANSPORTATION

STATE CONTRACT OR REF. NO. PROJECT NO. BRS-0137(13)
CONTRACTOR J. A. McDONALD, INC.
IN CHARGE: abs MADE BY: PPP CHK'D BY: LD DATE: 2-2-96
CONTRACT NUMBER: VT-95367 DRAWING NUMBER: 9 OF 24
CODE: 30

400-9 G3A-400