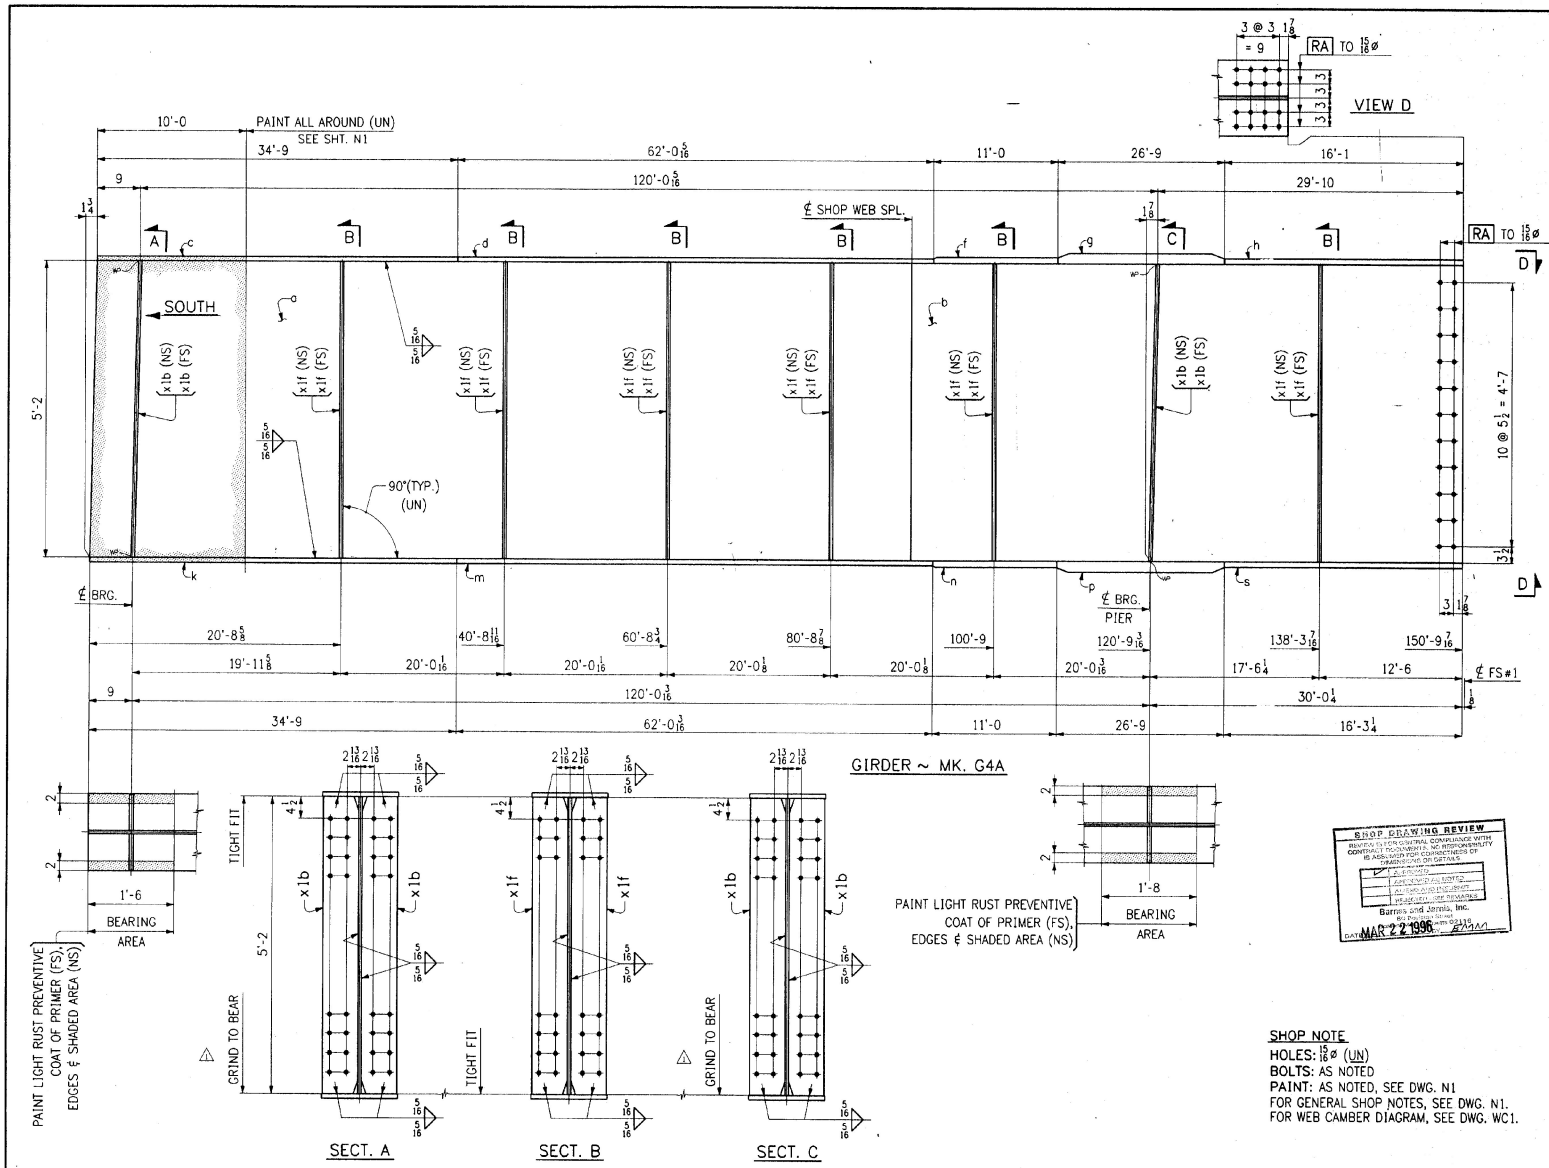

SHOP NOTE
HOLES: 15/16ø (UN)
BOLTS: AS NOTED
PAINT: AS NOTED, SEE DWG. N1
FOR GENERAL SHOP NOTES, SEE DWG. N1.
FOR WEB CAMBER DIAGRAM, SEE DWG. WC1.

SHOP DRAWING REVIEW
Barnes and Jarnis, Inc.
MAR 22 1996

FED.ROAD DIV.NO.	STATE	FED. AID PROJ. NO.
	VT	

BILL OF MATERIAL

NO.	MARK	DESCRIPTION	LENGTH		REMARKS	ITEM	SHT	WEIGHT
ONE	G4A	GIRDER						40865
1	a	PL 62 x ⅜	88	9	(T)	2	3	
1	b	PL 62 x ⅜	62	0 1/16	(T)	2	5	
1	c	PL 16 x 15/16	34	9	(T)	2	18	
1	d	PL 16 x 15/16	62	0 1/16	(T)	2	17	
1	f	PL 16 x 1¼	11	0	(T)	2	11	
1	g	PL 16 x 2 3/16	26	9	(T)	2	9	
1	h	PL 16 x 1⅛	16	1	(T)	2	15	
1	k	PL 16 x 15/16	34	9	(T)	2	18	
1	m	PL 16 x 15/16	62	0 1/16	(T)	2	17	
1	n	PL 16 x 1¼	11	0	(T)	2	11	
1	p	PL 16 x 2 3/16	26	9	(T)	2	9	
1	s	PL 16 x 1⅛	16	3¼	(T)	2	15	
4	x1b	BAR 7½ x ⅜	5	2		3	12	
12	x1f	BAR 7½ x ½	5	2		3	14	

NO.	REVISION	DATE
1	CHANGED "MILL" TO "GRIND"	2-21-96

HIGH STEEL STRUCTURES, INC.
1770 Hempstead Road
Lancaster, PA 17605-0908
Phone 717/299-5211
A Division of High Industries, Inc.

GIRDER G4A
U.S. ROUTE 7 OVER OTTER CREEK
BRIDGE NO. 79
TOWN OF WALLINGFORD, COUNTY OF RUTLAND
STATE OF VERMONT
AGENCY OF TRANSPORTATION

STATE CONTRACT OR REF. NO. PROJECT NO. BRS-0137(13)
CONTRACTOR J. A. McDONALD, INC.
IN CHARGE: abs MADE BY: PPP 2-1 CHK'D BY: LD DATE: 2-2-96
CONTRACT NUMBER: VT-95367 DRAWING NUMBER: 10 OF 24

CODE: 30

400-9

G4A-400

MAR 27 1996