


ADM. INFO.		SHOP BILL				JOB NO. 9006	DRG. NO. 79-1
PAGE	LINE	NO.	DESCRIPTION	FT.	IN.	ASSEM. MARK	SHIPPING MARK	REMARKS	WEIGHT
		1	SCUPPER	7	4		S1-79		—
		1	Do	7	6		S2-79		—
		1	Do	7	4		S3-79		—
1	A	24	BAR 3/16 x 3/8	1	3½	b1			
1	B	6	BAR 3 x 4	1	4	b2			
1	C	6	BAR 5/16 x 4	1	3½	b3		BEND	
1	D	6	BAR 1/4 x 4	1	2½	b4			
1	E	9	1" ø BAR	1	26	r1			
1	G	3	TS 8 x 8 x 4	8	6¼	t1			
1	H	1	L 3 x 3 x 5/16	1	4½		A1-79		
1	H	1	Do		6½	a1			
1	I	6	3/4" ø H.S. BOLTS	1	3/4		FIELD	W/NUTS & WASHERS ASSEMBLY	

PAY ITEM 506.55

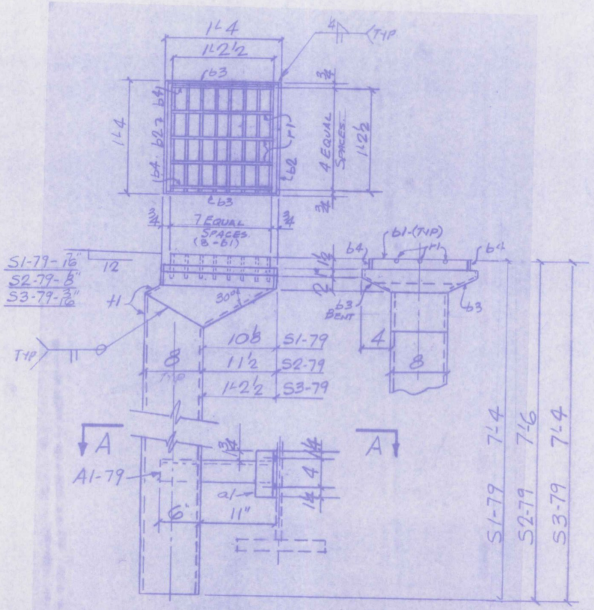

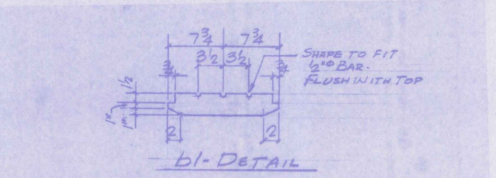

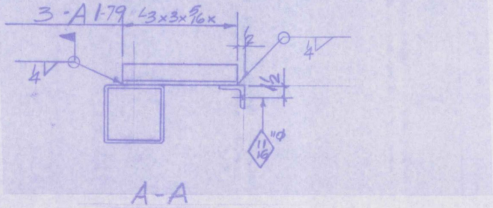

A-A

ONE - S1-79 (@ SECT. S1 - HIGH STEEL DWG. WS1)
ONE - S2-79 (@ SECT. S2 Do Do)
ONE - S3-79 (@ SECT. S3 Do Do)

WELDS - 4 CONT. FILLET U.N.

SHOP DRAWING REVIEW
REVIEW IS FOR GENERAL COMPLIANCE WITH CONTRACT DOCUMENTS. NO RESPONSIBILITY IS ASSUMED FOR CORRECTNESS OF DIMENSIONS OR DETAILS.
APPROVED
APPROVED AS NOTED
AMND AND RESUBMIT
REJECTED - SEE REMARKS
Barnes and Jarvis, Inc.
80 Montvale Street
Boston, Massachusetts 02116
DATE 3/20/96 BY C.K.

OUT FOR APPROVAL	3/7/96												
OUT FOR APPROVAL													
ISSUED TO SHOP													
FIELD & OFFICE													
REV.	REMARKS	DATE	DWN	CHK	APP	Q.A.	NO.	DIA.	LGT	TYPE	WASHER		

PROJECT NO. BRS-0137(13) BRIDGE No. 79

MATERIAL AASHTO M270 Gr 36 ELECTRODES:
HOLES AS NOTED SHOP BOLTS A325
SURFACE PREP. & PAINT:
GALVANIZED AFTER FAB ASTM-A123
GENERAL NOTES:

DESCRIPTION: SCUPPER DETAILS
JOB: U.S. RT. 7 OVER OTTER CREEK WALLINGFORD, VERMONT
CUSTOMER: J. A. Mc DONALD

DRAWN BY: JPF 2-27-96
CHKD BY: E.J.
APPROV BY:
Q.A.

BRIDGE & STEEL SERVICES
5 INDUSTRY ROAD SOUTH PORTLAND, ME. 04106
PHONE (207) 874-2017 FAX (207) 874-6998

JOB NO. 9006 DRG. NO. 79-1 REV.

HIGH STEEL JOB VT-95367-1