


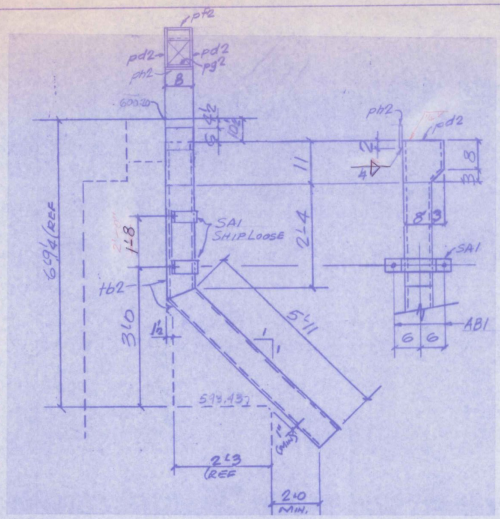


DS2-79-ONE REQ'D.
@ ABUT. 2

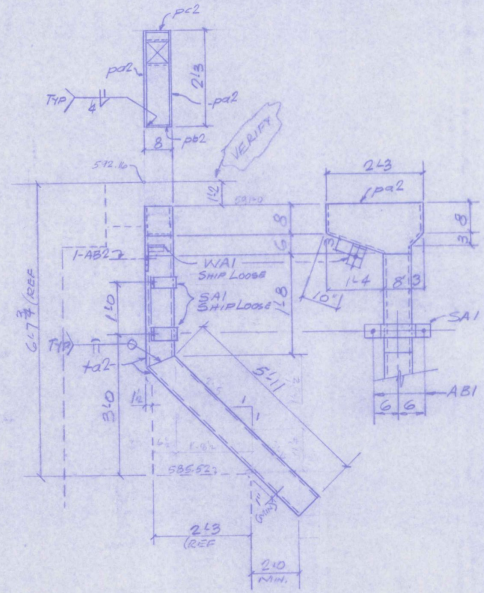


DS1-79-ONE REQ'D.
@ ABUT. 1

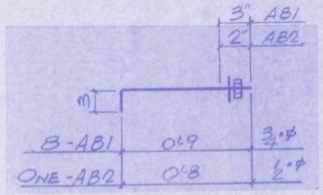

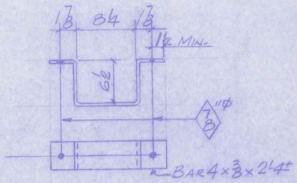

SA1-4 REQ'D

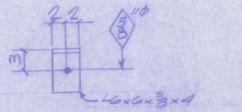

WA1-ONE REQ'D

ADM INFO	PAGE	LINE	NO.
	2	A	1
		B	2
	↓	B	1
	2	D	1
		1	2
	2	B	1
	↓	B	1
	↓	C	1
	2	E	1
	2	F	4
	2	G	1
	2	H	8
	2	I	1

OUT FOR
OUT FOR
ISSUED
FIELD &
REV. RE
PROJECT
MATERIAL
HOLES A
SURFACE
GALV
DESCRIP
JOB:
U.
CUSTOME
BR
5 IND
PHON