SHOP BILL

JOB NO. 9006 DRG. NO. 80-1

ABM INFO PAGE	LINE	NO.	DESCRIPTION	FT	IN	ASSEM. MARK	SHIPPING MARK	REMARKS	WEIGHT
			SCUPPER				SI-80		—
1	A	8	BAR 3½ x ⅜	1	3½	b1			
1	B	2	BAR 3 x 4	1	4	b2			
1	C	2	BAR 5½ x ¼	1	3½	b3		BEND	
1	D	2	BAR 12 x 4	1	2½	b4			
1	E	3	½"ø BAR	1	2½	r1			
1	F	1	PL 3 x 8 x ¼	6	0¾	t1			
1	H	1	L3 x 3 x 5/16	1	4½		A1-80		
1	H	1	Do		6½	a1	A1-80	BEND	
1	I	2	⅝" H.S. BOLTS		1¾		FIELD	WITH WASHER HDG GALV.	

PAY ITEM 506.55

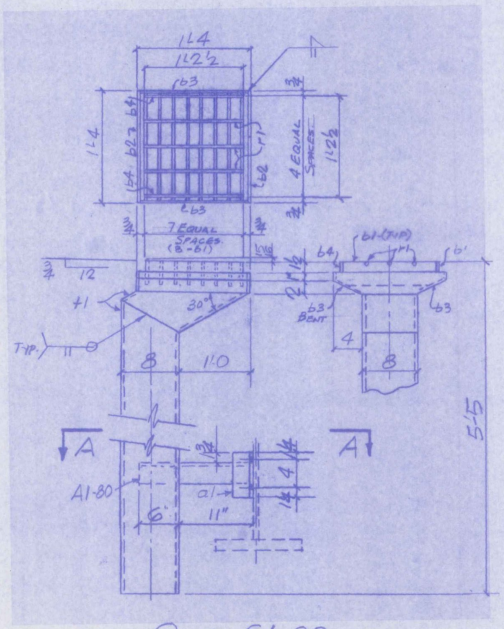

ONE-SI-80

WELDS - 4" CONT. FILLET U.N.

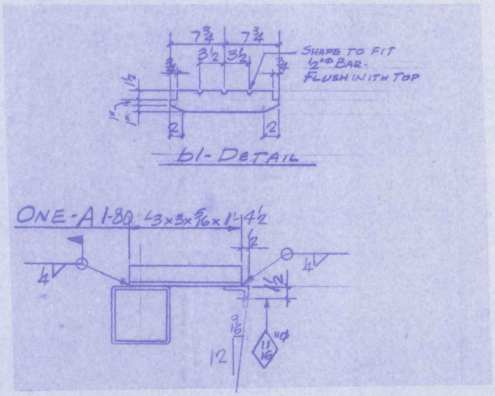

SHOP DRAWING REVIEW
REVIEW IS FOR GENERAL COMPLIANCE WITH CONTRACT DOCUMENTS. NO RESPONSIBILITY IS ASSUMED FOR CORRECTNESS OF DIMENSIONS OR DETAILS.
✓ APPROVED
APPROVED AS NOTED
AMEND AND RESUBMIT
REJECTED - SEE REMARKS
Barnes and Jarnis, Inc.
60 Boylston Street
Boston, Massachusetts 02116
DATE 3/26/96 BY CRC

REV.	REMARKS	DATE	DWN	CHK	APP	Q.A.	NO.	DIA.	LGT	TYPE	WASHER
	OUT FOR APPROVAL	3/26									
	OUT FOR APPROVAL										
	ISSUED TO SHOP										
	FIELD & OFFICE										

PROJECT NO. BRS-0137(13) BRIDGE NO. 80

MATERIAL: ASTM A709 GR 36 — ELECTRODES: — GENERAL NOTES:

HOLES: AS NOTED — SHOP BOLTS: ⅞" H.S.

SURFACE PREP. & PAINT:

GALVANIZED AFTER FAB. ASTM-A123

DESCRIPTION: SCUPPER DETAILS

JOB: U.S. RT. 7 OVER RAILROAD WALLINGFORD, VERMONT

CUSTOMER: J.A. McDONALD

	DRAWN BY	DATE
	J.P.F.	12-26-96
CHKD BY	E.J.	
APPROV. BY		
Q.A.		
JOB NO.	9006	
DRG. NO.	80-1	
REV.		

BRIDGE & STEEL SERVICES
5 INDUSTRY ROAD SOUTH PORTLAND, ME. 04106
PHONE (207) 874-2017 FAX. (207) 874-6998

HIGH STEEL JOB VT-95365-1