




GIRDER ~ MK. G1B

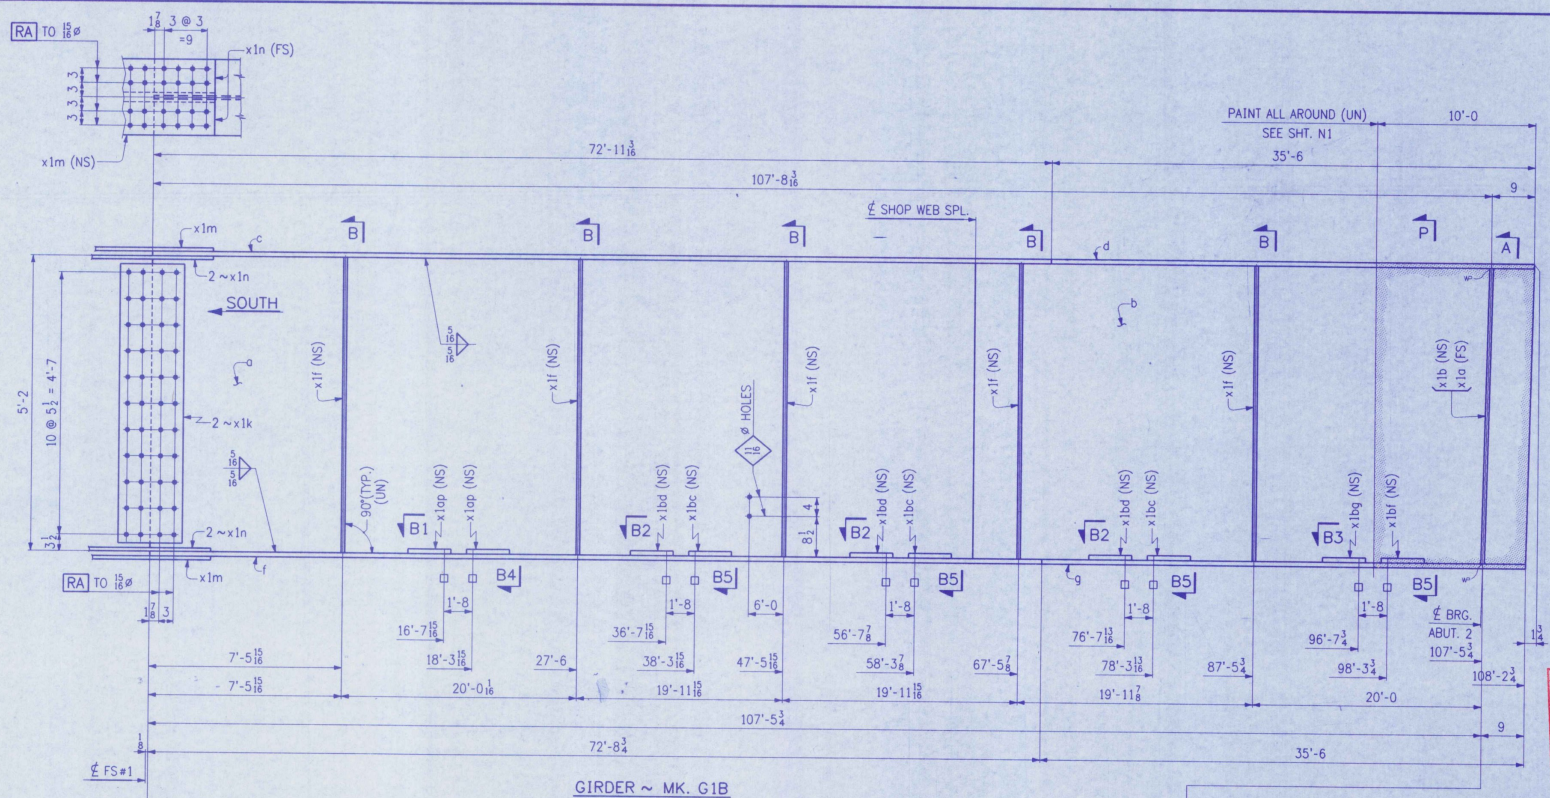


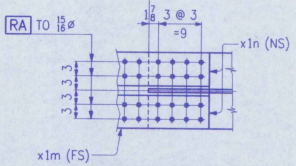


SECT. P

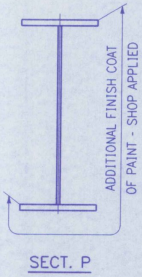

SECT. B4

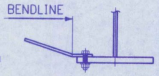

SECT. B5

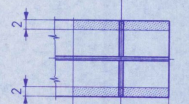

PAINT LIGHT RUST PREVENTIVE COAT OF PRIMER (FS), EDGES ℄ SHADED AREA (NS)

WORK THIS DWG. WITH DWG. 16

CODE: 30

FED. ROAD DIV. NO.	STATE	FED. AID PROJ. NO.
	VT	

SHOP DRAWING REVIEW
REVIEW IS FOR GENERAL COMPLIANCE WITH CONTRACT DOCUMENTS. NO RESPONSIBILITY IS ASSUMED FOR CORRECTNESS OF DIMENSIONS OR DETAILS.
APPROVED
APPROVED AS NOTED
AMEND AND RESUBMIT
RECEIVED - SEE REMARKS
Barnes and Jarmis, Inc.
DATE MAR 2 2 1996

NO.	REVISION	DATE
△		
△		
△		

HIGH STEEL STRUCTURES, INC.
1770 Hempstead Road
Lancaster, PA 17605-0008
Phone 717/299-5211
A Division of High Industries, Inc.

GIRDER G1B
U.S. ROUTE 7 OVER OTTER CREEK
BRIDGE NO. 79
TOWN OF WALLINGFORD, COUNTY OF RUTLAND
STATE OF VERMONT
AGENCY OF TRANSPORTATION

STATE CONTRACT OR REF. NO. PROJECT NO. BRS-0137(13)
CONTRACTOR J. A. McDONALD, INC.
IN CHARGE: abs MADE BY: PPP 2-2 CHK'D BY: LD DATE: 2-3-96
CONTRACT NUMBER: VT-95367 DRAWING NUMBER: 15 OF 24

400-9

G1B-400

MAR 0 1 1996