

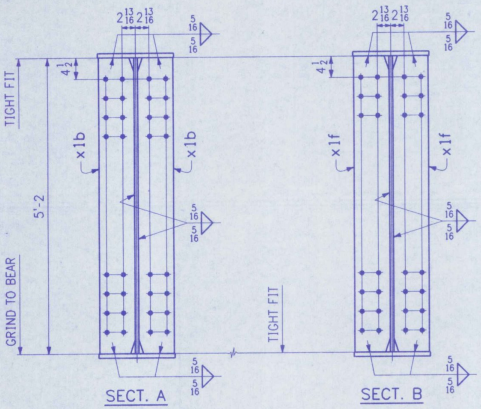



SECT. A SECT. B

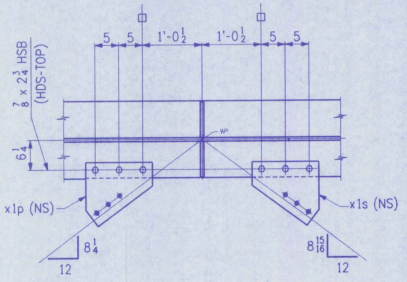


SECT. B1

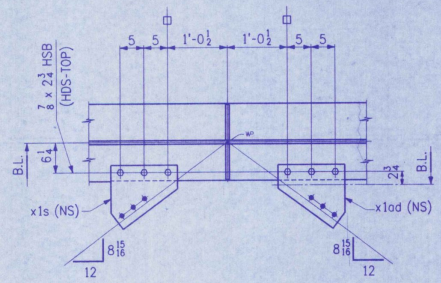


SECT. B2
(DEVELOPED FOR x1ad ONLY)

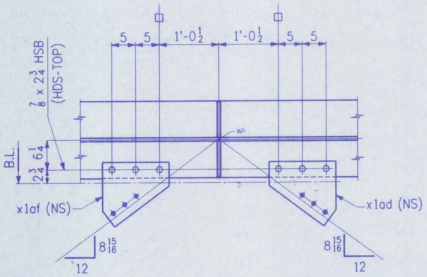

SECT. B3
(DEVELOPED)

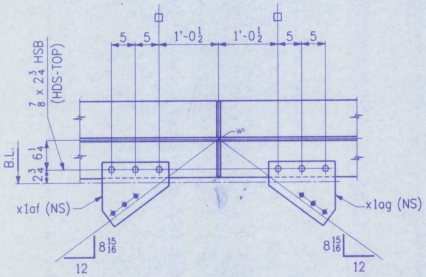



SECT. B4
(DEVELOPED)

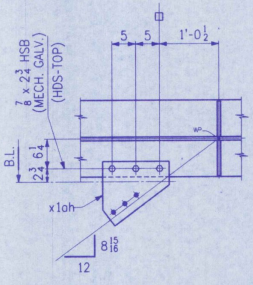


SECT. B5


NO.	MARK
ONE	G5B
1	a
1	b
1	c
1	d
1	f
1	g
2	x1k
2	x1m
4	x1n
2	x1b
10	x1f
1	x1p
2	x1s
3	x1ad
3	x1af
1	x1ag
1	x1ah
30	
30	
3	
3	

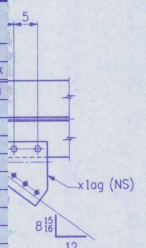

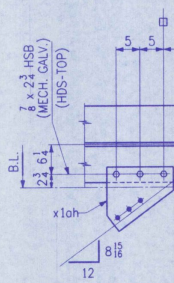

SECT

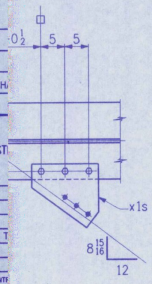

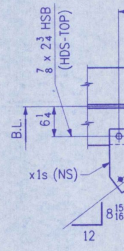

SHOP DRAWING REVIEW
REVIEWED FOR GENERAL COMPLIANCE WITH CONTRACT DOCUMENTS. NO RESPONSIBILITY IS ASSUMED FOR CORRECTNESS OF DIMENSIONS OR DETAILS.
APPROVED
APPROVED AS NOTED
AMEND AND RESUBMIT
REJECTED - SEE REMARKS
Barnes and Jarnis, Inc.
DATE MAR 2 2 1995 BY

SHOP NOTE
HOLES: $\frac{13}{16}$ ø (UN)
BOLTS: AS NOTED
PAINT: AS NOTED, SEE DWG. N1
FOR GENERAL SHOP NOTES, SEE DWG. N1.
FOR WEB CAMBER DIAGRAM, SEE DWG. WC1.

WORK THIS DWG. WITH DWG. 21

CODE: 30

NO.	
1	CH
NO.	

HIGH ST

STATE CONTR OR REF. NO.
CONTRACTOR
IN CHARGE:
CONTRACT NUMBER: