FED. ROAD DIV. NO.	STATE	FED. AID PROJ. NO.
	VT	

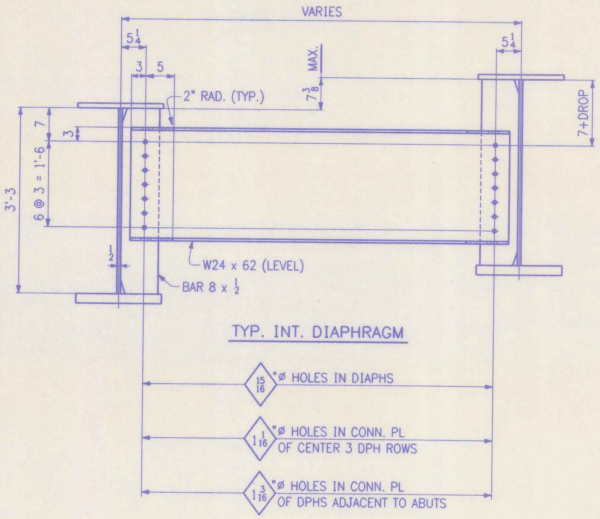

TYP. INT. DIAPHRAGM

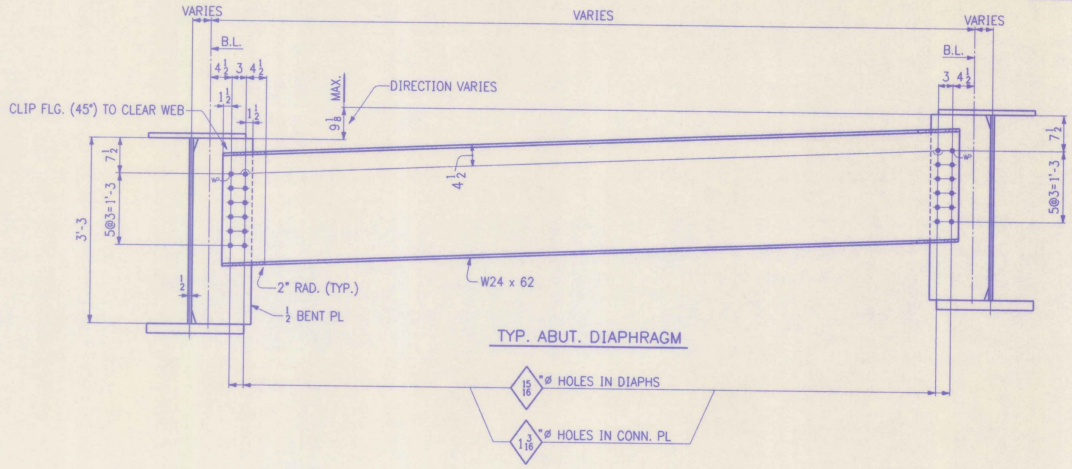

TYP. ABUT. DIAPHRAGM

SHOP DRAWING REVIEW
REVIEW IS FOR GENERAL COMPLIANCE WITH CONTRACT DOCUMENTS. NO RESPONSIBILITY IS ASSUMED FOR CORRECTNESS OF DETAILS.
X
Barnes and Jacobs, Inc.
60 Boylston Street
Boston, Massachusetts 02116
DATE 3-1-96 BY JAS

NO.	REVISION	DATE
△		
△		
△		

HIGH STEEL STRUCTURES, INC.
1770 Hampstead Road
Lancaster, PA 17605-0008
Phone 717/299-5211
A Division of High Industries, Inc.

WORKSHEET - LAYOUTS
U.S. ROUTE 7 OVER RAILROAD
BRIDGE NO. 80
TOWN OF WALLINGFORD, COUNTY OF RUTLAND
STATE OF VERMONT
AGENCY OF TRANSPORTATION

STATE CONTRACT OR REF. NO. PROJECT NO. BRS-0137(13)
CONTRACTOR J. A. McDONALD, INC.
IN CHARGE: abs MADE BY: LD 1-16 CHK'D BY: DATE: 1-23-96
CONTRACT NUMBER: VT-95368 DRAWING NUMBER: WS2

THIS IS A WORK (W) DRAWING. ITS FUNCTION IS TO PROVIDE BASIC DIMENSIONS AND CONCEPTS FOR USE IN THE PREPARATION OF THE SHOP DETAILS. IT IS NOT INTENDED TO BE USED FOR ERECTION OR FABRICATION.

401-3

LYOT401A