FED.ROAD DIV.NO.	STATE	FED. AID PROJ. NO.
	VT	

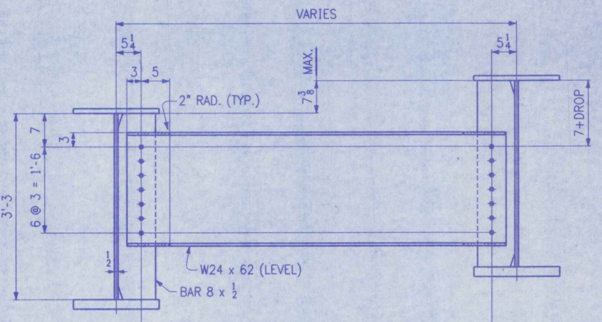

TYP. INT. DIAPHRAGM

15/16"Ø HOLES IN DIAPHS

1 1/16"Ø HOLES IN CONN. PL
OF CENTER 3 DPH ROWS

1 3/16"Ø HOLES IN CONN. PL
OF DPHS ADJACENT TO ABUTS

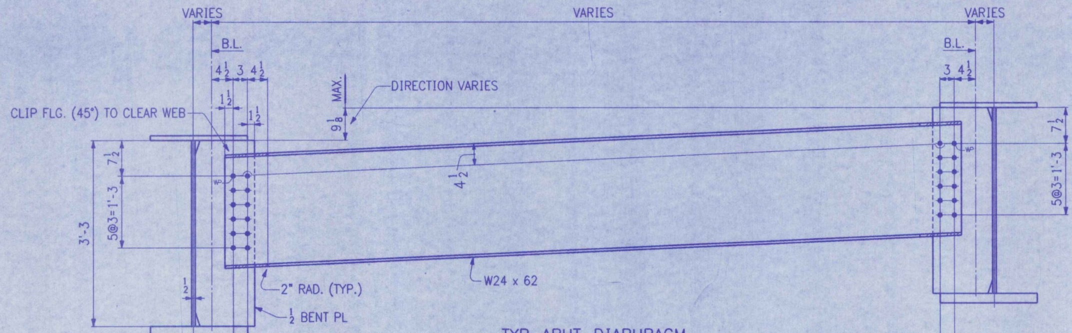

TYP. ABUT. DIAPHRAGM

15/16"Ø HOLES IN DIAPHS

1 3/16"Ø HOLES IN CONN. PL

SHOP DRAWING REVIEW

REVIEW IS FOR GENERAL COMPLIANCE WITH CONTRACT DOCUMENTS. NO RESPONSIBILITY IS ASSUMED FOR CORRECTNESS OF DIMENSIONS OR DETAILS.

X	APPROVED
	APPROVED AS NOTED
	AMEND AND RESUBMIT
	REJECTED - SEE REMARKS

Barnes and Jarnis, Inc.
80 Boylston Street
Boston, Massachusetts 02116
DATE 4-16-96 BY JAB

THIS IS A WORK (W) DRAWING. ITS FUNCTION IS TO PROVIDE BASIC DIMENSIONS AND CONCEPTS FOR USE IN THE PREPARATION OF THE SHOP DETAILS. IT IS NOT INTENDED TO BE USED FOR ERECTION OR FABRICATION.

NO.	REVISION	DATE
△		
△		
△		

HIGH STEEL STRUCTURES, INC.
1770 Hempstead Road
Lancaster, PA 17605-0008
Phone 717/299-5211
A Division of High Industries, Inc.

WORKSHEET - LAYOUTS
U.S. ROUTE 7 OVER RAILROAD
BRIDGE NO. 80
TOWN OF WALLINGFORD, COUNTY OF RUTLAND
STATE OF VERMONT
AGENCY OF TRANSPORTATION

STATE CONTRACT OR REF. NO. PROJECT NO. BRS-0137(13)
CONTRACTOR J. A. McDONALD, INC.
IN CHARGE: abs MADE BY: LD 1-16 CHK'D BY: JK DATE: 1-23-96
CONTRACT NUMBER: VT-95368 DRAWING NUMBER: WS2

MAR 2 1