

FED.ROAD DIV.NO.	STATE	FED. AID PROJ. NO.
	VT	

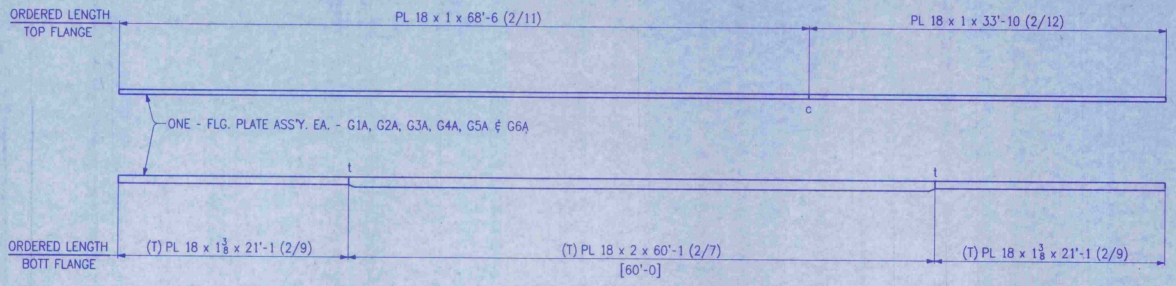

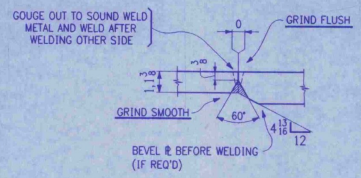

TYP. FLG. SPLICE DET.
(B-L2c-S)

NOTES:

1. FOR GENERAL SHOP NOTES SEE DRAWING N1.
2. THE LETTERS "t" & "c" AT FLANGE SPLICES INDICATE TENSION AND COMPRESSION SPLICES RESPECTIVELY.
3. SPLICES MARKED (t) TO BE RADIOGRAPHICALLY TESTED 100%. SPLICES MARKED (c) TO BE RADIOGRAPHICALLY TESTED 25%.
4. (T) INDICATES PLATES THAT REQUIRE CHARPY V-NOTCH TEST.
5. DIMENSIONS SHOWN THUS: [60'-0] ARE THE ACTUAL DIMENSIONS THAT WILL APPEAR ON THE DETAIL DRAWINGS.

SHOP DRAWING REVIEW
REVIEW IS FOR GENERAL COMPLIANCE WITH CONTRACT DOCUMENTS. NO RESPONSIBILITY IS ASSUMED FOR CORRECTNESS OF DIMENSIONS OR DETAILS.
X APPROVED
APPROVED AS NOTED
AWAITING RESUBMIT
REJECTED - SEE REMARKS
Barnes and Jarvis, Inc.
80 Boylston Street
Boston, Massachusetts 02116
DATE 4-16-96 BY JGR

NO.	REVISION	DATE
△		
△		
△		

HIGH STEEL STRUCTURES, INC.
1770 Hempstead Road
Lancaster, PA 17605-0008
Phone 717/299-5211
A Division of High Industries, Inc.

FLANGE SPLICE DETAILS
U.S. ROUTE 7 OVER RAILROAD
BRIDGE NO. 80
TOWN OF WALLINGFORD, COUNTY OF RUTLAND
STATE OF VERMONT
AGENCY OF TRANSPORTATION

STATE CONTRACT OR REF. NO. PROJECT NO. BRS-0137(13)
CONTRACTOR J. A. McDONALD, INC.
IN CHARGE: abs MADE BY: LD 1-29 CHK'D BY: DATE: 1-30-96
CONTRACT NUMBER: VT-95368 DRAWING NUMBER: FS1

CODE: 30

401-4

FS1-401

MAR 21 1996