
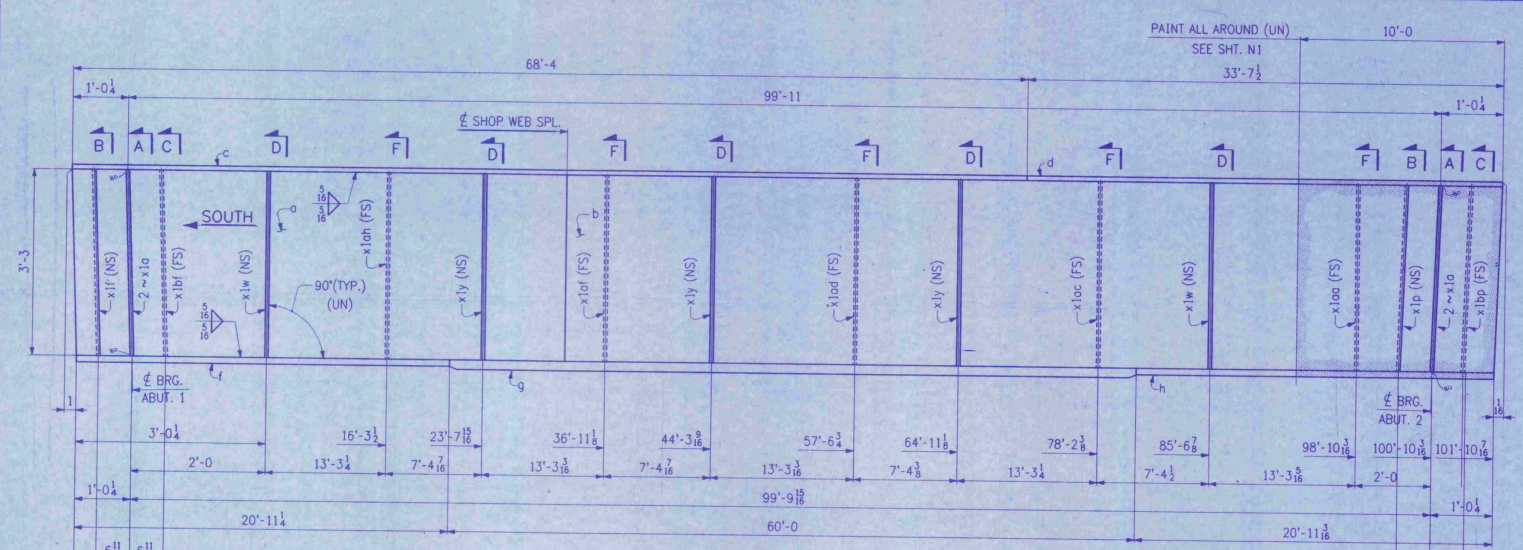


GIRDER ~ MK. G4A

PAINT LIGHT RUST PREVENTIVE COAT OF PRIMER (FS), EDGES ℄ SHADED AREA (NS)

PAINT LIGHT RUST PREVENTIVE COAT OF PRIMER (FS), EDGES ℄ SHADED AREA (NS)

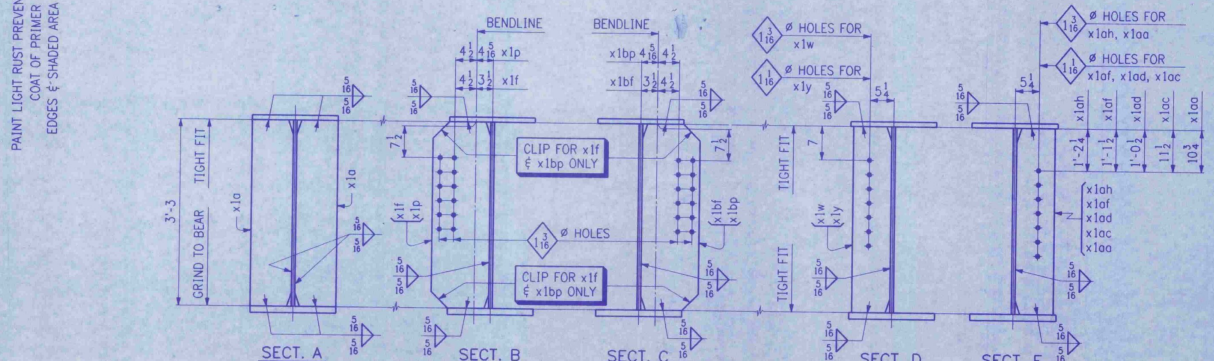

SHOP DRAWING REVIEW
REVIEWED FOR GENERAL COMPLIANCE WITH CONTRACT DOCUMENTS. NO EXCEPTIONS TAKEN.
Baines and James, Inc.
DATE 4-16-96

SHOP NOTE
HOLES: 15/16ø (UN)
BOLTS: NONE
PAINT: AS NOTED, SEE DWG. N1
FOR GENERAL SHOP NOTES, SEE DWG. N1.
FOR WEB CAMBER DIAGRAM, SEE DWG. WC1.

CODE: 30

FED. ROAD DIV. NO. | STATE: VT | FED. AID PROJ. NO.

BILL OF MATERIAL

NO.	MARK	DESCRIPTION	LENGTH		REMARKS	ITEM	SHIP WEIGHT EA.
ONE	G4A	GIRDER					24,950
1	a	PL 39 x ½	32	3¼	(T)	2 3	
1	b	PL 39 x ½	69	8 7/16	(T)	2 2	
1	c	PL 18 x 1	68	4		2 11	
1	d	PL 18 x 1	33	7½		2 12	
1	f	PL 18 x 1⅜	20	11¼	(T)	2 9	
1	g	PL 18 x 2	60	0	(T)	2 7	
1	h	PL 18 x 1⅜	20	11 13/16	(T)	2 9	
4	x1a	PL 8¾ x ⅞	3	3		3 2	
1	x1f	PL 39 11/16 x ½	1	0¼	BENT	3 4	
1	x1p	PL 39⅛ x ½	1	1 1/16	BENT	3 4	
1	x1bf	PL 39 11/16 x ½	1	0¼	BENT	3 4	
1	x1bp	PL 39⅛ x ½	1	1 1/16	BENT	3 4	
2	x1w	BAR 8 x ½	3	3		3 5	
3	x1y	BAR 8 x ½	3	3		3 5	
1	x1aa	BAR 8 x ½	3	3		3 5	
1	x1ac	BAR 8 x ½	3	3		3 5	
1	x1ad	BAR 8 x ½	3	3		3 5	
1	x1af	BAR 8 x ½	3	3		3 5	
1	x1ah	BAR 8 x ½	3	3		3 5	

NO.	REVISION	DATE
△		
△		
△		

HIGH STEEL STRUCTURES, INC.
1770 Hempstead Road
Lancaster, PA 17605-0008
Phone 717/299-5211
A Division of High Industries, Inc.

GIRDER G4A
U.S. ROUTE 7 OVER RAILROAD
BRIDGE NO. 80
TOWN OF WALLINGFORD, COUNTY OF RUTLAND
STATE OF VERMONT
AGENCY OF TRANSPORTATION

STATE CONTRACT OR REF. NO. PROJECT NO. BRS-0137(13)
CONTRACTOR J. A. McDONALD, INC.
IN CHARGE: abs MADE BY: PPP 2-15 CHK'D BY: FM DATE: 2-20-96
CONTRACT NUMBER: VT-95368 DRAWING NUMBER: 7 OF 9

401-9 G4A-401

MAR 21 1996