
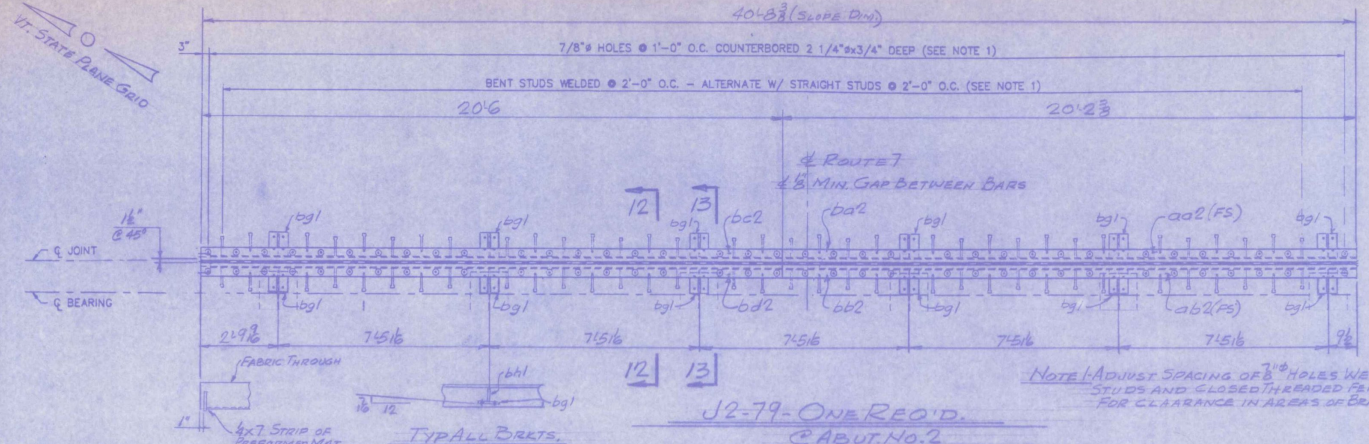



NOTE 1: ADJUST SPACING OF 7/8"ø HOLES WELDED STUDS AND CLOSED THREADED FERRULES FOR CLEARANCE IN AREAS OF BRACKETS

J2-79 - ONE REQ'D. @ ABUT. NO. 2

DRIP BEAD DET.

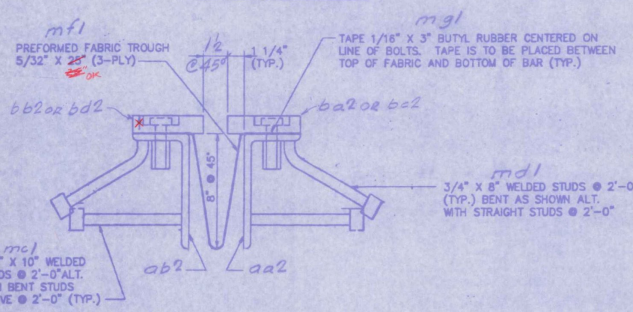

SECTION 12-12

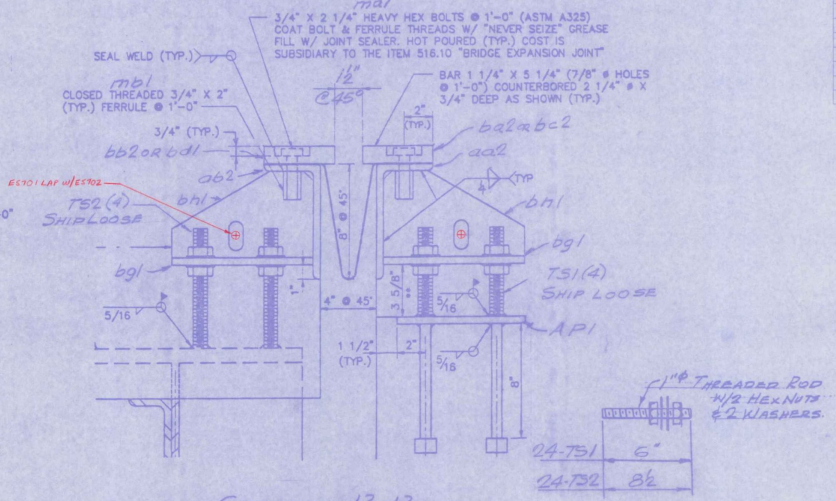

SECTION 13-13

SHOP BILL

JOB NO. 9007 DRG. NO. 79-2

PAGE	LINE	NO.	DESCRIPTION	FT	IN	ASSEM. MARK	SHIPPING MARK	REMARKS	WEIGHT
		1	ASSEMBLY	40	8 3/8		J2-79		
1	A	1	PL 3/8 x 4 x 1/2	40	8 3/8	aa2			
	A	1	Do	40	8 3/8	ab2			
	C	1	BAR 5/4 x 1/4	20	2 3/8	ba2			
	C	1	Do	20	2 3/8	bb2			
	B	1	Do	20	6	bc2			
	B	1	Do	20	6	bd2			
	D	12	PL 1/2 x 8		10	bg1			
	E	12	PL 1/2 x 6		10	bh1			
	F	82	3/4"ø H.S. BOLTS		24	ma1		A325	
	G	82	3/4"ø H.S. CLOSED THREADED FERRULES		2	mb1		THREADED	
	H	42	3/4"ø STUD ANCS		10	mc1			
	I	42	Do			md1			
	K	1	PLYWOOD 5/32 x 25 OK JK	40	9	mf1		(3 PLY)	
1	L	2	STEEL ROD 3/8 x 8 1/2 STUDS	40	9	mg1			
1	J	6	PL 1/2 x 8		9		API		
1	E	24	3/4"ø STUD ANC'S		8	md1			
1	M	24	1"ø THREADED ROD		6		TS1	W/2 NUTS & WASH.	
1	N	24	Do		8 1/2		TS2	Do	
		9	4 x 4 x 3/8 L	1	0	sa1			
		18	3/4"ø H.S. BOLTS		3			W/1 WASH.	

PAY ITEM 516.10

SHOP DRAWING REVIEW
REVIEW IS FOR GENERAL COMPLIANCE WITH CONTRACT DOCUMENTS. NO RESPONSIBILITY IS ASSUMED FOR CORRECTNESS OF DIMENSIONS OR DETAILS.
APPROVED
APPROVED AS NOTED
AMEND AND RESUBMIT
REJECTED - SEE REMARKS
Barnes and Jarnis, Inc.
80 Boylston Street
Boston, Massachusetts 02116
DATE 3/2/96 BY OK


OUT FOR APPROVAL	3/4/96									
OUT FOR APPROVAL										
ISSUED TO SHOP										
FIELD & OFFICE										
REV.	REMARKS	DATE	DWN	CHK	APP	Q.A.	NO.	DIA.	LGT	TYPE	WASHER

PROJECT NO: BRS-0137(13) BRIDGE NO. 79
MATERIAL: AASHTO M270 GR 36 ELECTRODES:
HOLES: AS NOTED SHOP BOLTS: 3/4"ø H.S.
SURFACE PREP. & PAINT: GALVANIZED AFTER FAB.
GENERAL NOTES: 40'-8 3/8" 40.70 L.F.
DESCRIPTION: EXP. JOINT - ABUT. NO. 2
JOB: U.S. RT. 7 OVER OTTER CREEK WALLINGFORD, VERMONT
CUSTOMER: U.A. McDONALD


	DRAWN BY	DATE
	JPF	2-28-96
CHKD BY	E.N.	
APPROV BY		
Q.A.		

BRIDGE & STEEL SERVICES
5 INDUSTRY ROAD SOUTH PORTLAND, ME. 04106
PHONE (207) 874-2017 FAX. (207) 874-5998


JOB NO. 9007 DRG. NO. 79-2 REV.

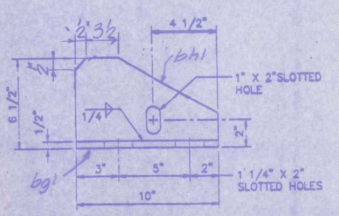


BRACKET ELEVATION

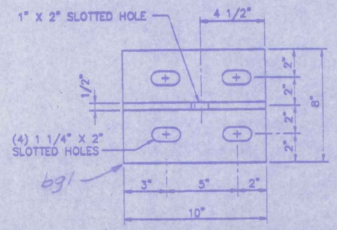

BRACKET PLAN

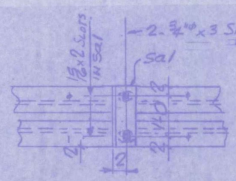

SHIPPING DEVICE SPACED 5'-0" O.C. MAX.

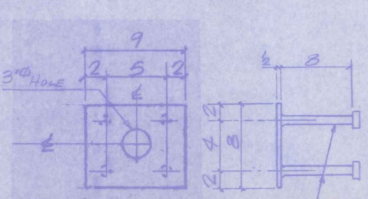

API-6 REQ'D