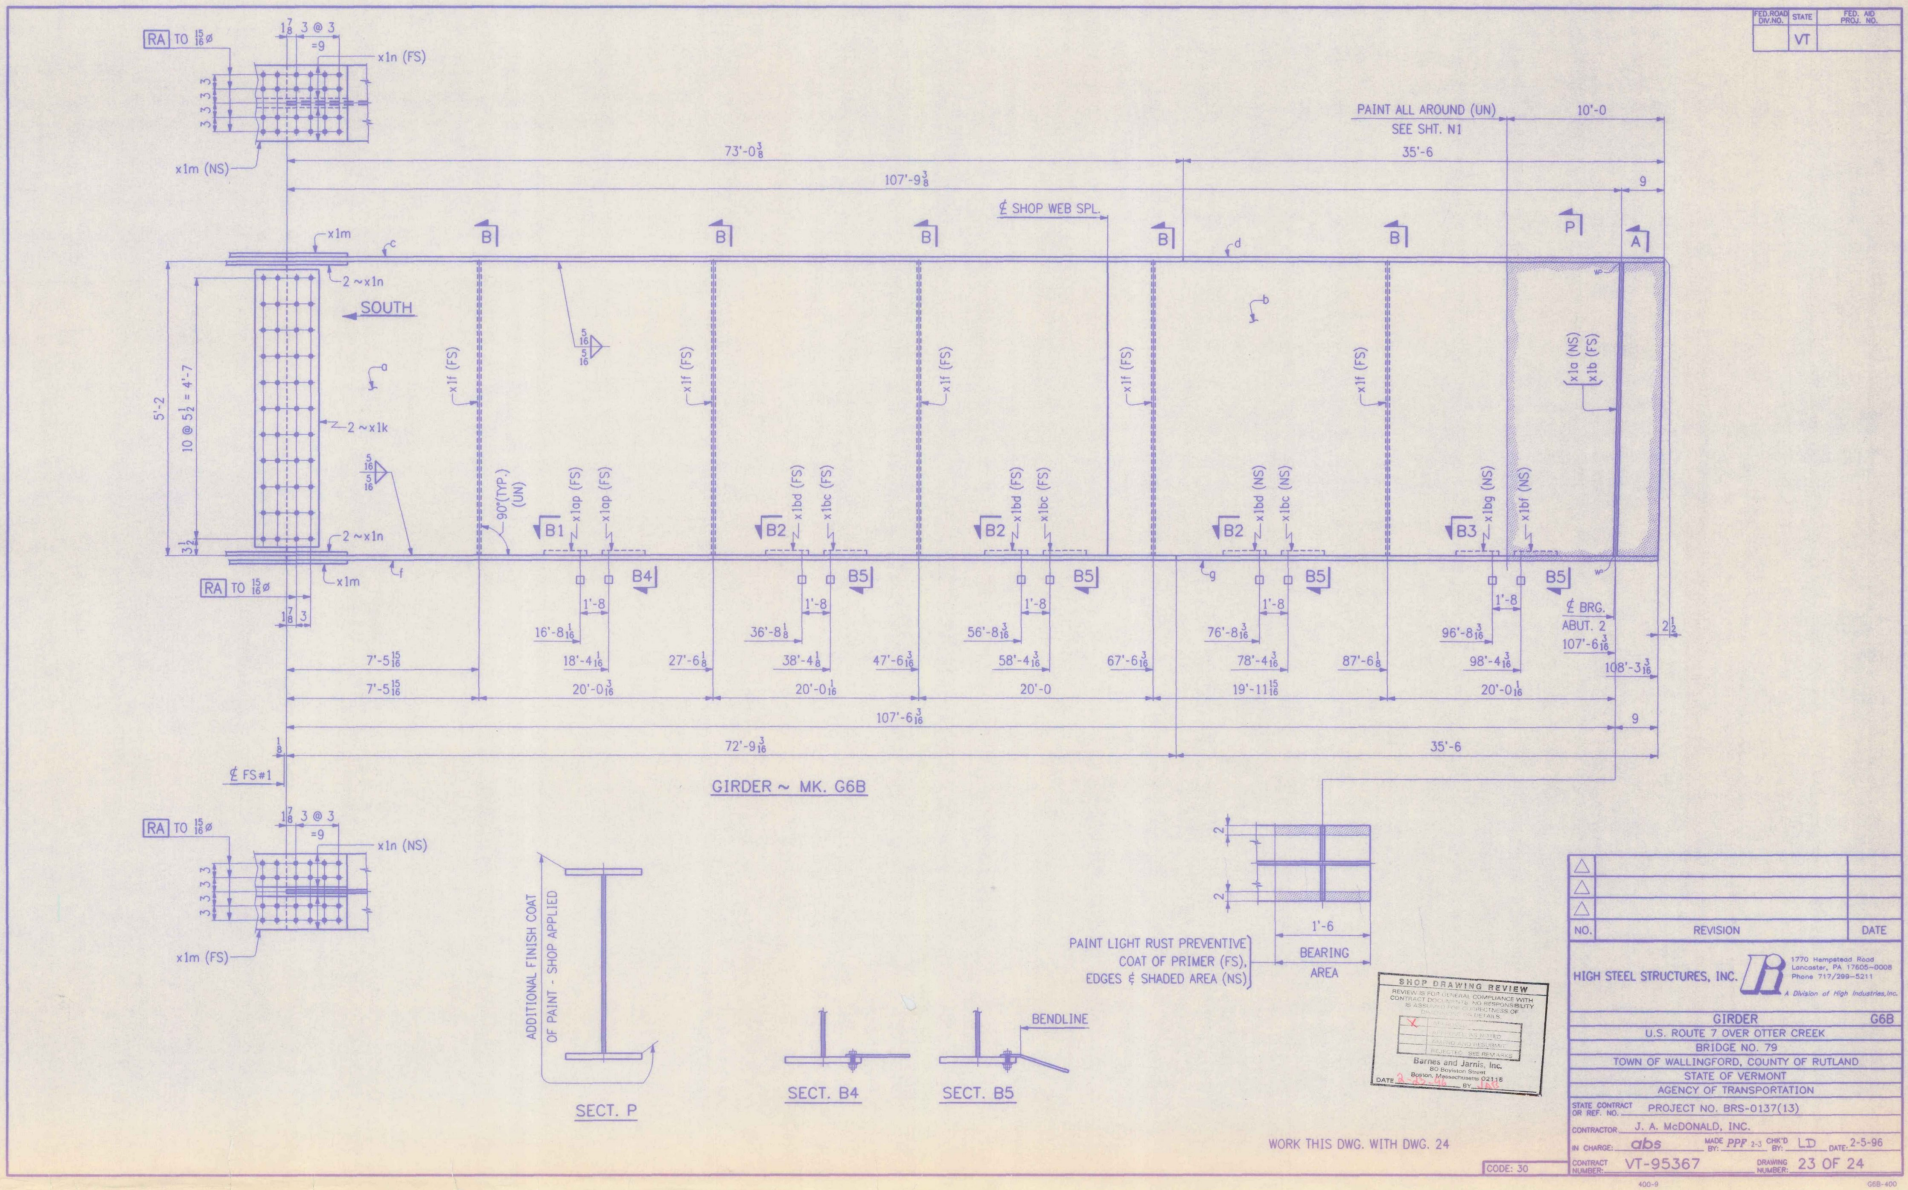

FED. ROAD DIV. NO.
STATE
VT
FED. AID PROJ. NO.
RA TO 15/16 ø
x1n (FS)
x1m (NS)
PAINT ALL AROUND (UN)
SEE SHT. N1
10'-0
73'-0 3/8
35'-6
107'-9 3/8
9
℄ SHOP WEB SPL.
x1m
2 ~ x1n
SOUTH
2 ~ x1k
5'-2
10 @ 5 1/2 = 4'-7
x1f (FS)
x1a (NS)
x1b (FS)
90°(TYP.) (UN)
x1ap (FS)
x1bd (FS)
x1bc (FS)
x1bd (NS)
x1bc (NS)
x1bg (NS)
x1bf (NS)
B1
B2
B3
B4
B5
1'-8
16'-8 1/16
18'-4 1/16
27'-6 1/8
36'-8 1/8
38'-4 1/8
47'-6 3/16
56'-8 3/16
58'-4 3/16
67'-6 3/16
76'-8 3/16
78'-4 3/16
87'-6 1/8
96'-8 3/16
98'-4 3/16
℄ BRG. ABUT. 2
107'-6 3/16
108'-3 3/16
7'-5 15/16
20'-0 3/16
20'-0 1/16
20'-0
19'-11 15/16
107'-6 3/16
72'-9 3/16
℄ FS#1
GIRDER ~ MK. G6B
ADDITIONAL FINISH COAT OF PAINT - SHOP APPLIED
SECT. P
SECT. B4
SECT. B5
BENDLINE
PAINT LIGHT RUST PREVENTIVE COAT OF PRIMER (FS), EDGES & SHADED AREA (NS)
1'-6
BEARING AREA
SHOP DRAWING REVIEW
Barnes and Jarnis, Inc.
80 Boylston Street
Boston, Massachusetts 02116
WORK THIS DWG. WITH DWG. 24
CODE: 30
NO.
REVISION
DATE
HIGH STEEL STRUCTURES, INC.
1770 Hempstead Road
Lancaster, PA 17605-0008
Phone 717/299-5211
A Division of High Industries, Inc.
GIRDER G6B
U.S. ROUTE 7 OVER OTTER CREEK
BRIDGE NO. 79
TOWN OF WALLINGFORD, COUNTY OF RUTLAND
STATE OF VERMONT
AGENCY OF TRANSPORTATION
STATE CONTRACT OR REF. NO. PROJECT NO. BRS-0137(13)
CONTRACTOR J. A. McDONALD, INC.
IN CHARGE: abs
MADE BY: PPP 2-3
CHK'D BY: LD
DATE: 2-5-96
CONTRACT NUMBER: VT-95367
DRAWING NUMBER: 23 OF 24
400-9
G6B-400