


NORTH RAILING LOOKING NORTH (VIEWING TRAFFIC FACE)
U.S. ROUTE 7 OVER OTTER CREEK, BRIDGE No 79

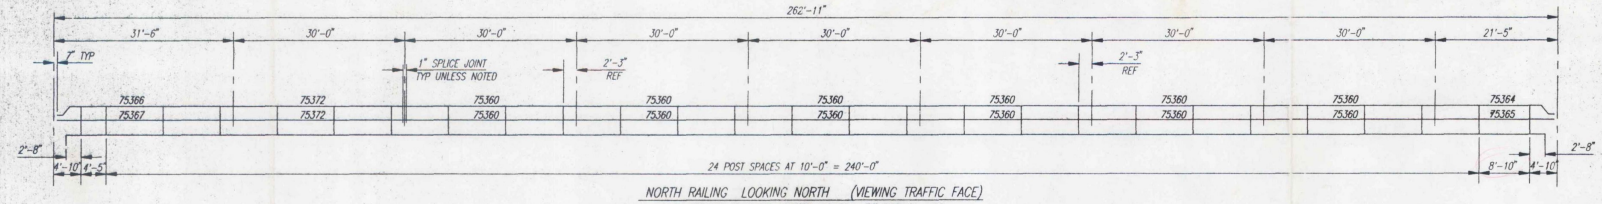


SOUTH RAILING LOOKING NORTH (VIEWING REAR FACE)
U.S. ROUTE 7 OVER OTTER CREEK, BRIDGE No 79




NORTH RAILING LOOKING NORTH (VIEWING TRAFFIC FACE)
U.S. ROUTE 7 OVER RAILROAD, BRIDGE No 80

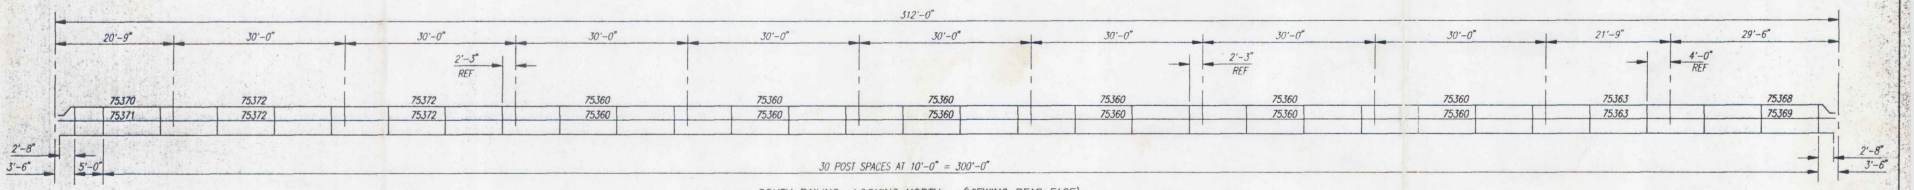


SOUTH RAILING LOOKING NORTH (VIEWING REAR FACE)
U.S. ROUTE 7 OVER RAILROAD, BRIDGE No 80

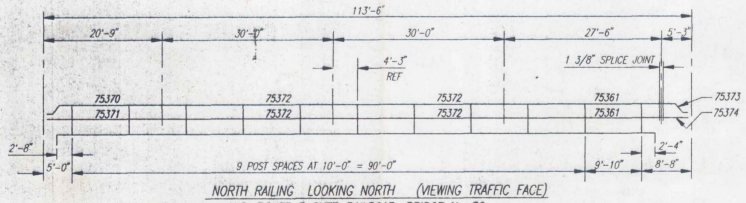


RAILING PLAN




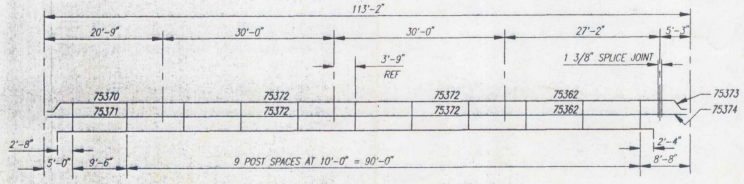


RAILING PLAN

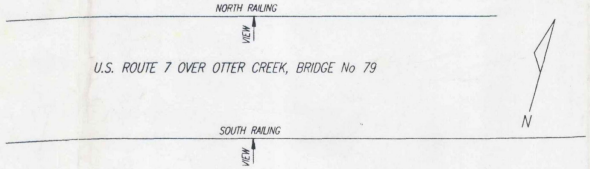ISSUED
APR 1 8 1996
ISSUED

SHOP DETAILS ARE ON SHEETS 1 & 2 OF 2 (22) 101571

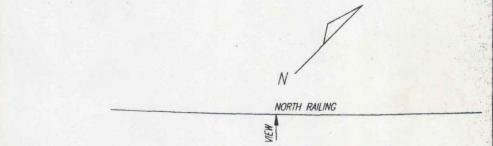NOTES:
1. ALL POSTS ARE PC No 14392
2. ALL SPLICES ARE PC No 32124
3. INSPECTED BY CONWELL
4. FINISH: GALV A123
5. TOTAL PAY LENGTH 801'-7"

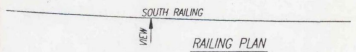SHOP DRAWING REVIEW
REVIEW IS FOR GENERAL COMPLIANCE WITH CONTRACT DOCUMENTS ONLY AND DOES NOT IMPLY ASSUMED FOR DIMENSIONS OR DETAILS
APPROVED
APPROVED AS NOTED
REVISE AND RESUBMIT
REJECTED - SEE REMARKS
Barnes and Jarnis, Inc.
DATE 5-10-96

Rec 5-21-96

Wallingford B3501371(13)

This drawing and the information shown thereon is the sole property of TRINITY INDUSTRIES, INC. Neither the drawing nor such information is to be used for any purpose other than that for which it was specifically furnished by TRINITY INDUSTRIES, INC., nor is any reproduction authorized without written permission.

APPROVAL DRAWING

| REV. | CHK'D | BY | DATE | REMARKS |
|---|---|---|---|---|
| | | | | |

STATE OF VERMONT
AGENCY OF TRANSPORTATION
BOX BEAM BRIDGE RAILING
TOWN OF WALLINGFORD, COUNTY OF RUTLAND
U.S. ROUTE 7, BRIDGE No 79 & No 80
PROJECT: BRS 0137 (13)

CUSTOMER F.R. LAFAYETTE INC. P.O. No.

TRINITY INDUSTRIES, INC.
DALLAS, TX CENTERVILLE, UT GIRARD, OH LIMA, OH FORT WORTH, TX ELIZABETHTOWN, KY
SYRO

| | |
|---|---|
| DRAWN | B. TAKACH |
| CHECKED | T.P. |
| APPROVED | |
| DATE | 4-11-96 |
| ENG. FILE # | 101571E1 |
| SHT. No. | E1 OF 2 |
| DRAWING No. | (22) 101571 |
| REV. | 0 |