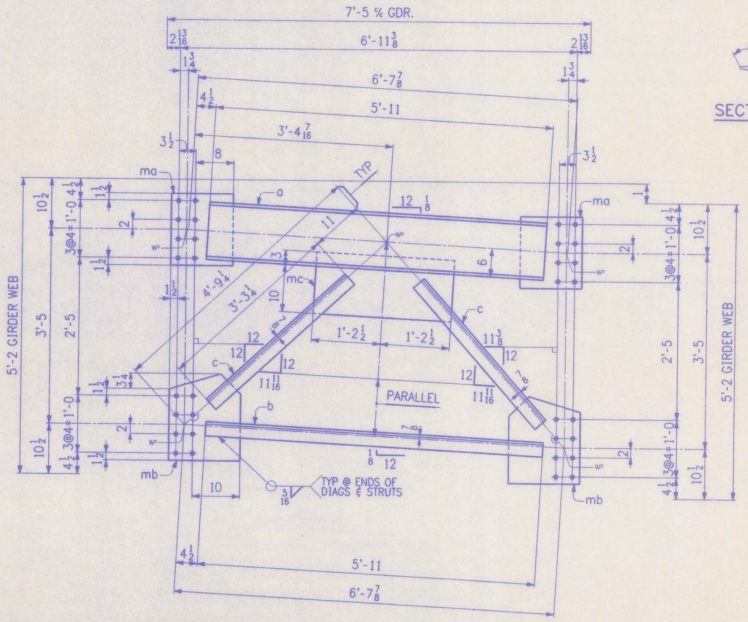

CROSSFRAME ~ CF1

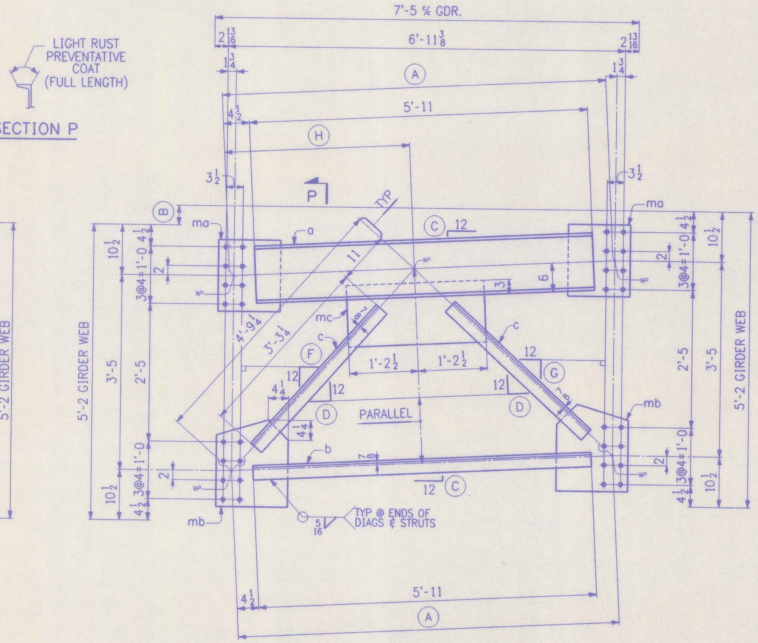

SECTION P

CROSSFRAMES

	MARK	Ⓐ	Ⓑ	Ⓒ	Ⓓ	Ⓕ	Ⓖ	Ⓗ
PAINT	CF2	6'-8	4 3/4	11/16	11 3/4	10 7/16	10 7/8	3'-1 9/16
	CF3	6'-7 15/16	3 1/4	1/2	11 11/16	10 13/16	11 5/16	3'-2 5/16

SHOP DRAWING REVIEW
REVIEW IS FOR GENERAL COMPLIANCE WITH CONTRACT DOCUMENTS. RESPONSIBILITY IS ASSUMED FOR ALL DETAILS.
X
APPROVED AS NOTED
APPROVED AS NOTED/RESUBMIT
REJECTED / RESUBMIT
Barnes and Jarnis, Inc.
815 Boylston Street
Boston, Massachusetts 02116
DATE 4-25-96 BY

SHOP NOTE
HOLES: 15/16 ø
BOLTS: NONE
PAINT: AS NOTED, SEE DWG. N1.
FOR GENERAL SHOP NOTES, SEE DWG. N1.

CODE: 63

FED. ROAD DIV. NO.	STATE	FED. AID PROJ. NO.
	VT	

BILL OF MATERIAL

NO.	MARK	DESCRIPTION	LENGTH		REMARKS	ITEM	SHIP WEIGHT
5	CF1	CROSSFRAMES					414
5	a	MC12 x 31	5	11		4 5	
5	b	L3 x 3 x 3/8	5	11		4 2	
10	c	L3 x 3 x 3/8	3	3 1/4		4 2	
10	ma	PL 13 x 3/8	1	3		4 3	
10	mb	PL 15 x 3/8	1	6 1/4		4 3	
5	mc	PL 13 x 3/8	2	5		4 3	
5	CF2	CROSSFRAMES			PAINTED		414
5	CF3	CROSSFRAMES			PAINTED		414
10	a	MC12 x 31	5	11		4 5	
10	b	L3 x 3 x 3/8	5	11		4 2	
20	c	L3 x 3 x 3/8	3	3 1/4		4 2	
20	ma	PL 13 x 3/8	1	3		4 3	
20	mb	PL 15 x 3/8	1	6 1/4		4 3	
10	mc	PL 13 x 3/8	2	5		4 3	

NO.	REVISION	DATE
△		
△		
△		

HIGH STEEL STRUCTURES, INC.
1770 Hampstead Road
Lancaster, PA 17605-0008
Phone 717/299-5211
A Division of High Industries, Inc.

CROSSFRAMES (END & PIER)
U.S. ROUTE 7 OVER OTTER CREEK
BRIDGE NO. 79
TOWN OF WALLINGFORD, COUNTY OF RUTLAND
STATE OF VERMONT
AGENCY OF TRANSPORTATION

STATE CONTRACT OR REF. NO. PROJECT NO. BRS-0137(13)
CONTRACTOR J. A. McDONALD, INC.
IN CHARGE: abs MADE BY: PPF 1-22 CHK'D BY: DATE: 1-28-96
CONTRACT NUMBER: VT-95367 DRAWING NUMBER: 3 OF 24

400-13 400CF1