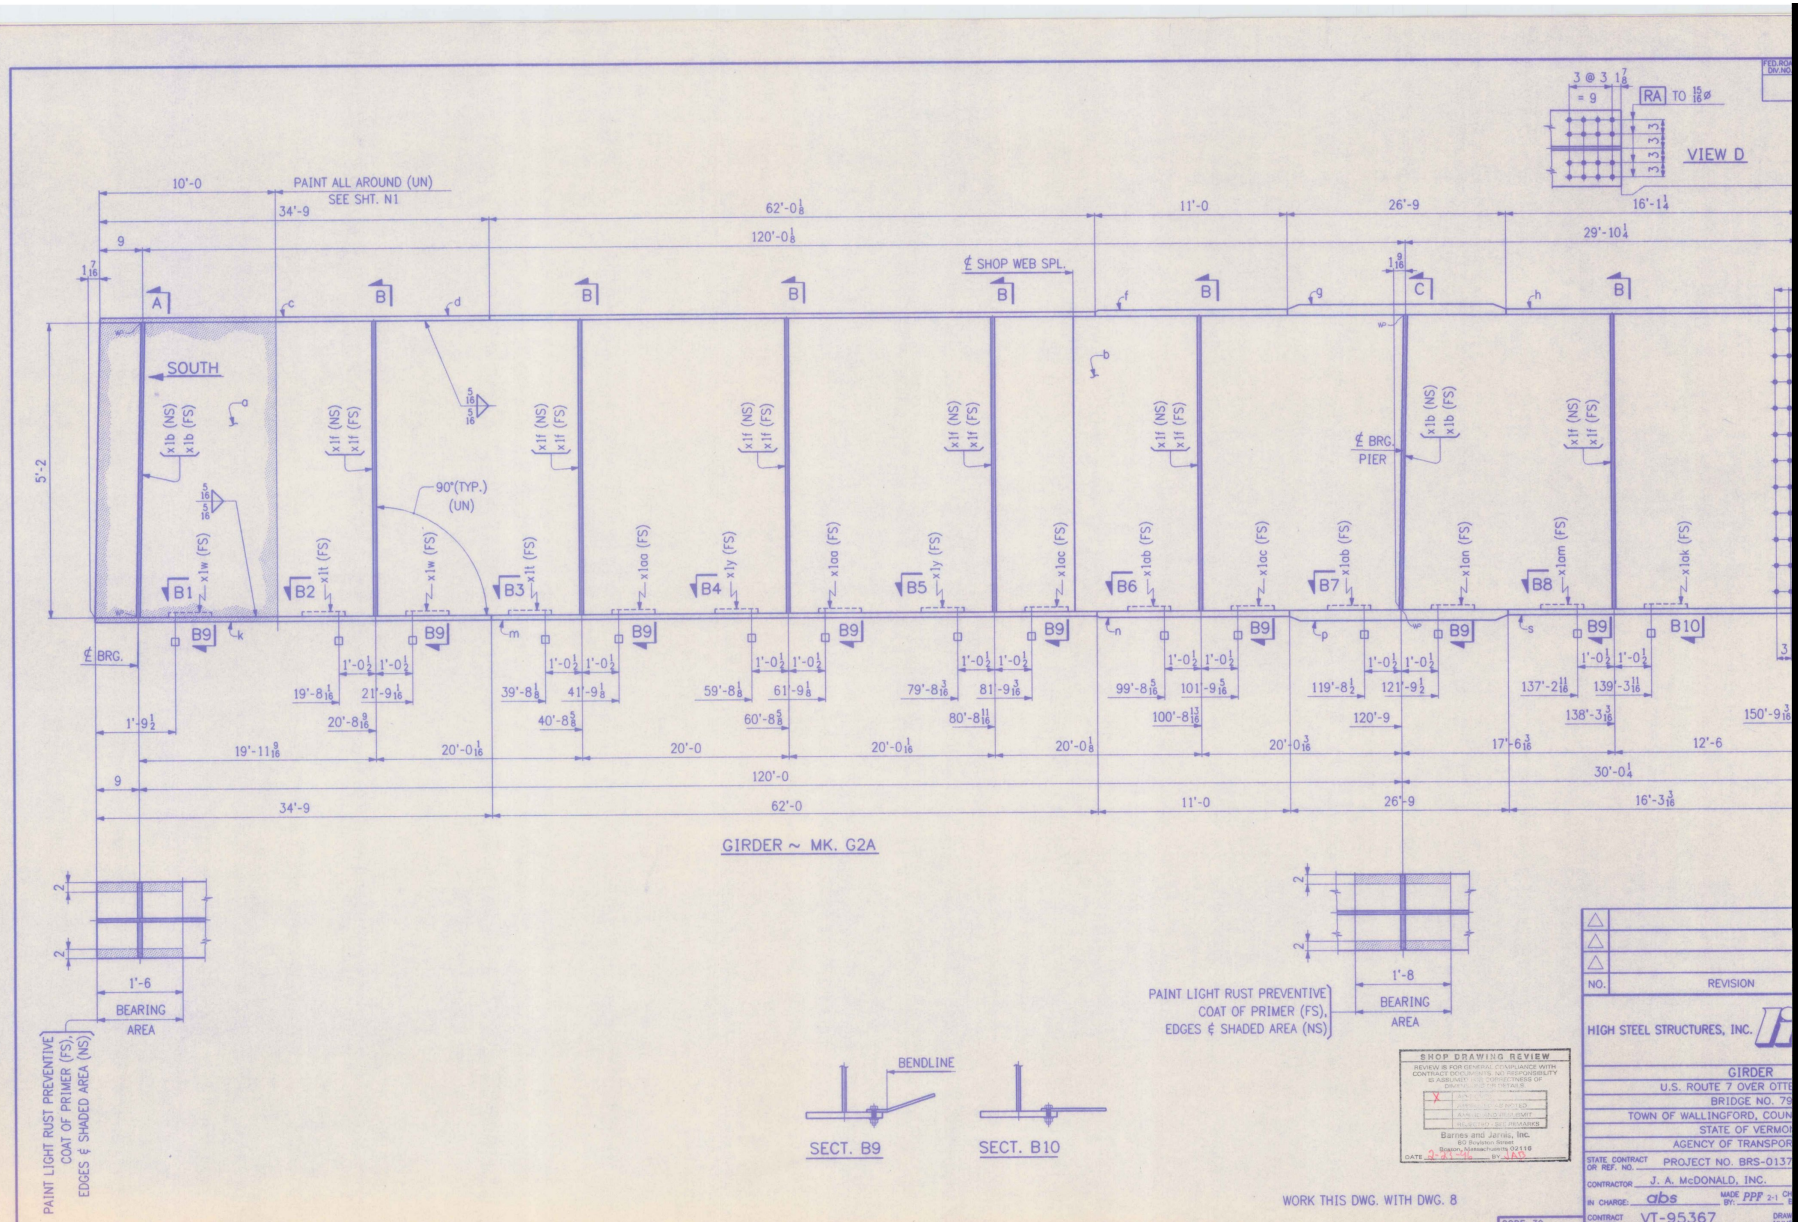
VIEW D
PAINT ALL AROUND (UN)
SEE SHT. N1
SOUTH
℄ SHOP WEB SPL.
℄ BRG.
PIER
90°(TYP.)
(UN)
5'-2
GIRDER ~ MK. G2A
BEARING
AREA
PAINT LIGHT RUST PREVENTIVE
COAT OF PRIMER (FS),
EDGES & SHADED AREA (NS)
BENDLINE
SECT. B9
SECT. B10
SHOP DRAWING REVIEW
Barnes and Jarnis, Inc.
WORK THIS DWG. WITH DWG. 8
CODE: 30
NO.
REVISION
HIGH STEEL STRUCTURES, INC.
GIRDER
U.S. ROUTE 7 OVER OTTE
BRIDGE NO. 79
TOWN OF WALLINGFORD, COUN
STATE OF VERMO
AGENCY OF TRANSPOR
STATE CONTRACT OR REF. NO.
PROJECT NO. BRS-0137
CONTRACTOR
J. A. McDONALD, INC.
IN CHARGE:
MADE BY:
CONTRACT NUMBER:
VT-95367