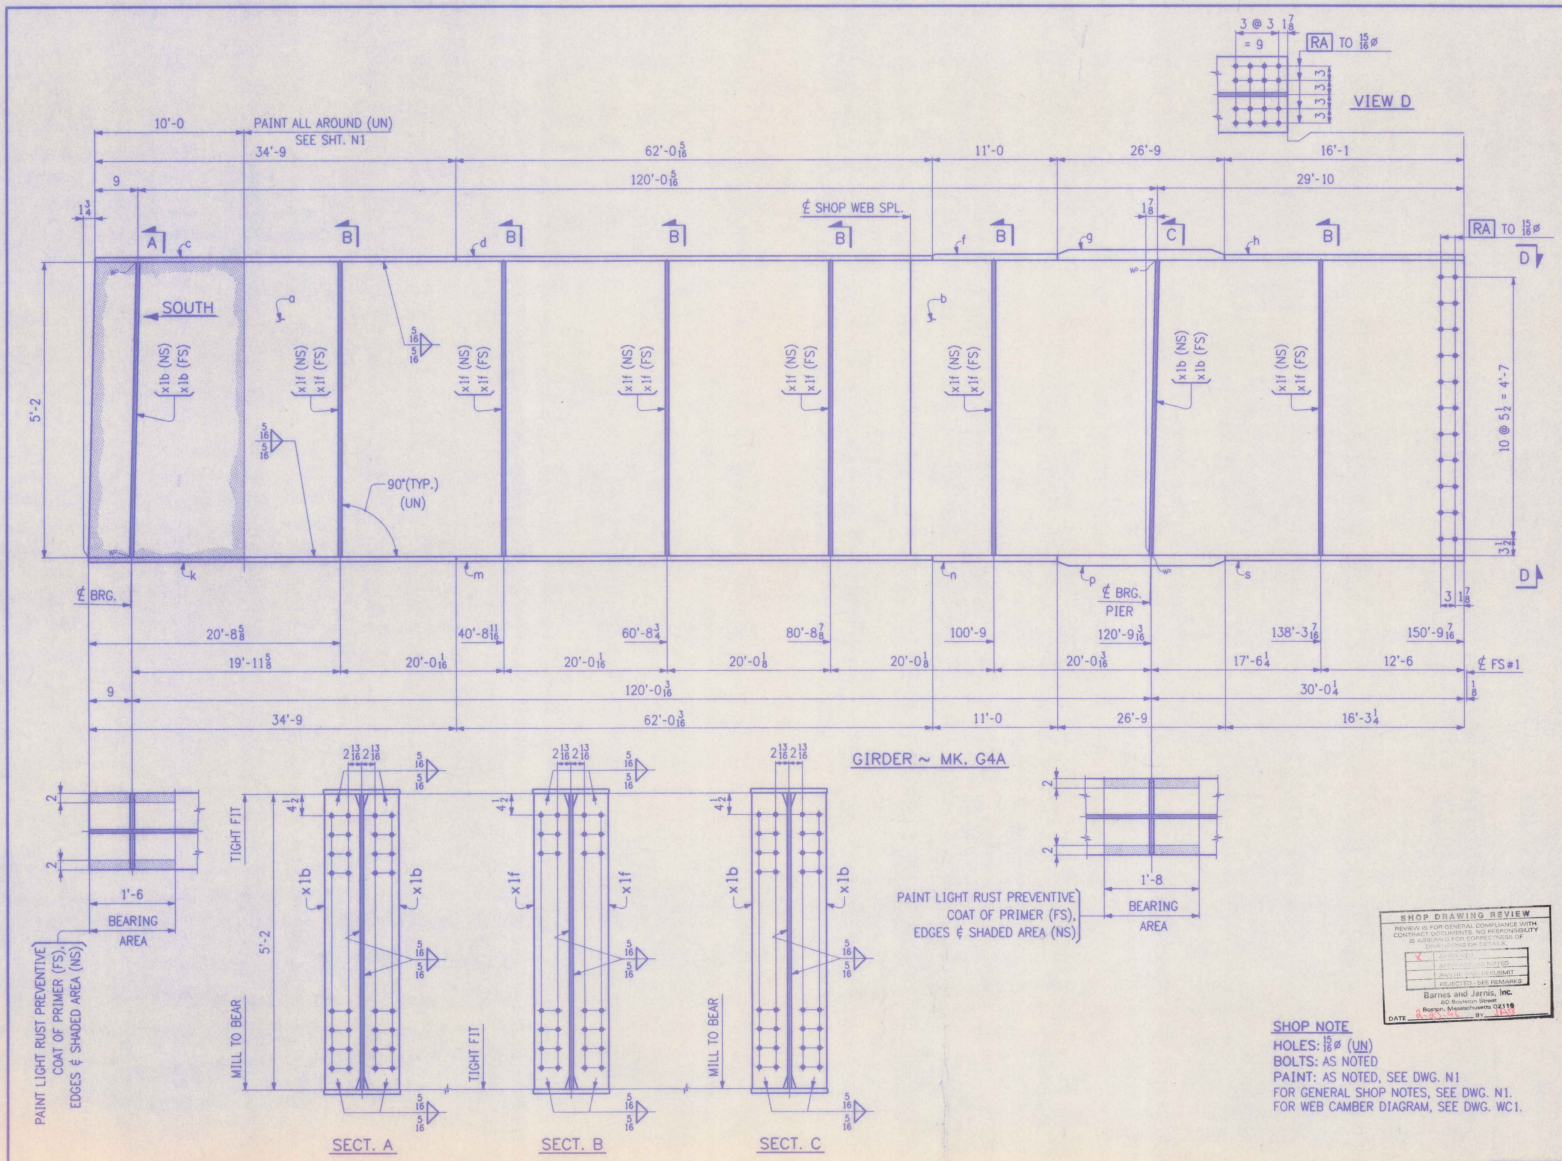

FED. ROAD DIV. NO.	STATE	FED. AID PROJ. NO.
	VT	

BILL OF MATERIAL

NO.	MARK	DESCRIPTION	LENGTH		REMARKS	ITEM	SHIP WEIGHT LB.
ONE	G4A	GIRDER					40865
1	a	PL 62 x 5/8	88	9	(T)	2/3	
1	b	PL 62 x 3/8	62	0 7/16	(T)	2/2	
1	c	PL 16 x 15/16	34	9	(T)	2/18	
1	d	PL 16 x 15/16	62	0 5/16	(T)	2/17	
1	f	PL 16 x 1 1/4	11	0	(T)	2/11	
1	g	PL 16 x 2 5/16	26	9	(T)	2/9	
1	h	PL 16 x 1 1/8	16	1	(T)	2/15	
1	k	PL 16 x 15/16	34	9	(T)	2/18	
1	m	PL 16 x 15/16	62	0 5/16	(T)	2/17	
1	n	PL 16 x 1 1/4	11	0	(T)	2/11	
1	p	PL 16 x 2 3/16	26	9	(T)	2/9	
1	s	PL 16 x 1 1/8	16	3 1/4	(T)	2/15	
4	x1b	BAR 7 1/2 x 7/8	5	2		3/12	
12	x1f	BAR 7 1/2 x 1/2	5	2		3/14	

SHOP NOTE
HOLES: 15/16ø (UN)
BOLTS: AS NOTED
PAINT: AS NOTED, SEE DWG. N1
FOR GENERAL SHOP NOTES, SEE DWG. N1.
FOR WEB CAMBER DIAGRAM, SEE DWG. WC1.

SHOP DRAWING REVIEW
REVIEW IS FOR GENERAL COMPLIANCE WITH CONTRACT DOCUMENTS. NO RESPONSIBILITY IS ASSUMED FOR CORRECTNESS OF DIMENSIONS OR DETAILS.
APPROVED
APPROVED AS NOTED
RESUBMIT
REJECTED - SEE REMARKS
Barnes and Jarnis, Inc.
60 Boylston Street
Boston, Massachusetts 02116
DATE 2-2-96 BY: [illegible]

CODE: 30

NO.	REVISION	DATE
△		
△		
△		

HIGH STEEL STRUCTURES, INC.
1770 Hampstead Road
Lancaster, PA 17605-0008
Phone 717/299-5211
A Division of High Industries, Inc.

GIRDER G4A
U.S. ROUTE 7 OVER OTTER CREEK
BRIDGE NO. 79
TOWN OF WALLINGFORD, COUNTY OF RUTLAND
STATE OF VERMONT
AGENCY OF TRANSPORTATION

STATE CONTRACT OR REF. NO. PROJECT NO. BRS-0137(13)
CONTRACTOR J. A. McDONALD, INC.
IN CHARGE: abs MADE BY: PPF 2-1 CHK'D BY: LD DATE: 2-2-96
CONTRACT NUMBER: VT-95367 DRAWING NUMBER: 10 OF 24

400-9 G4A-400