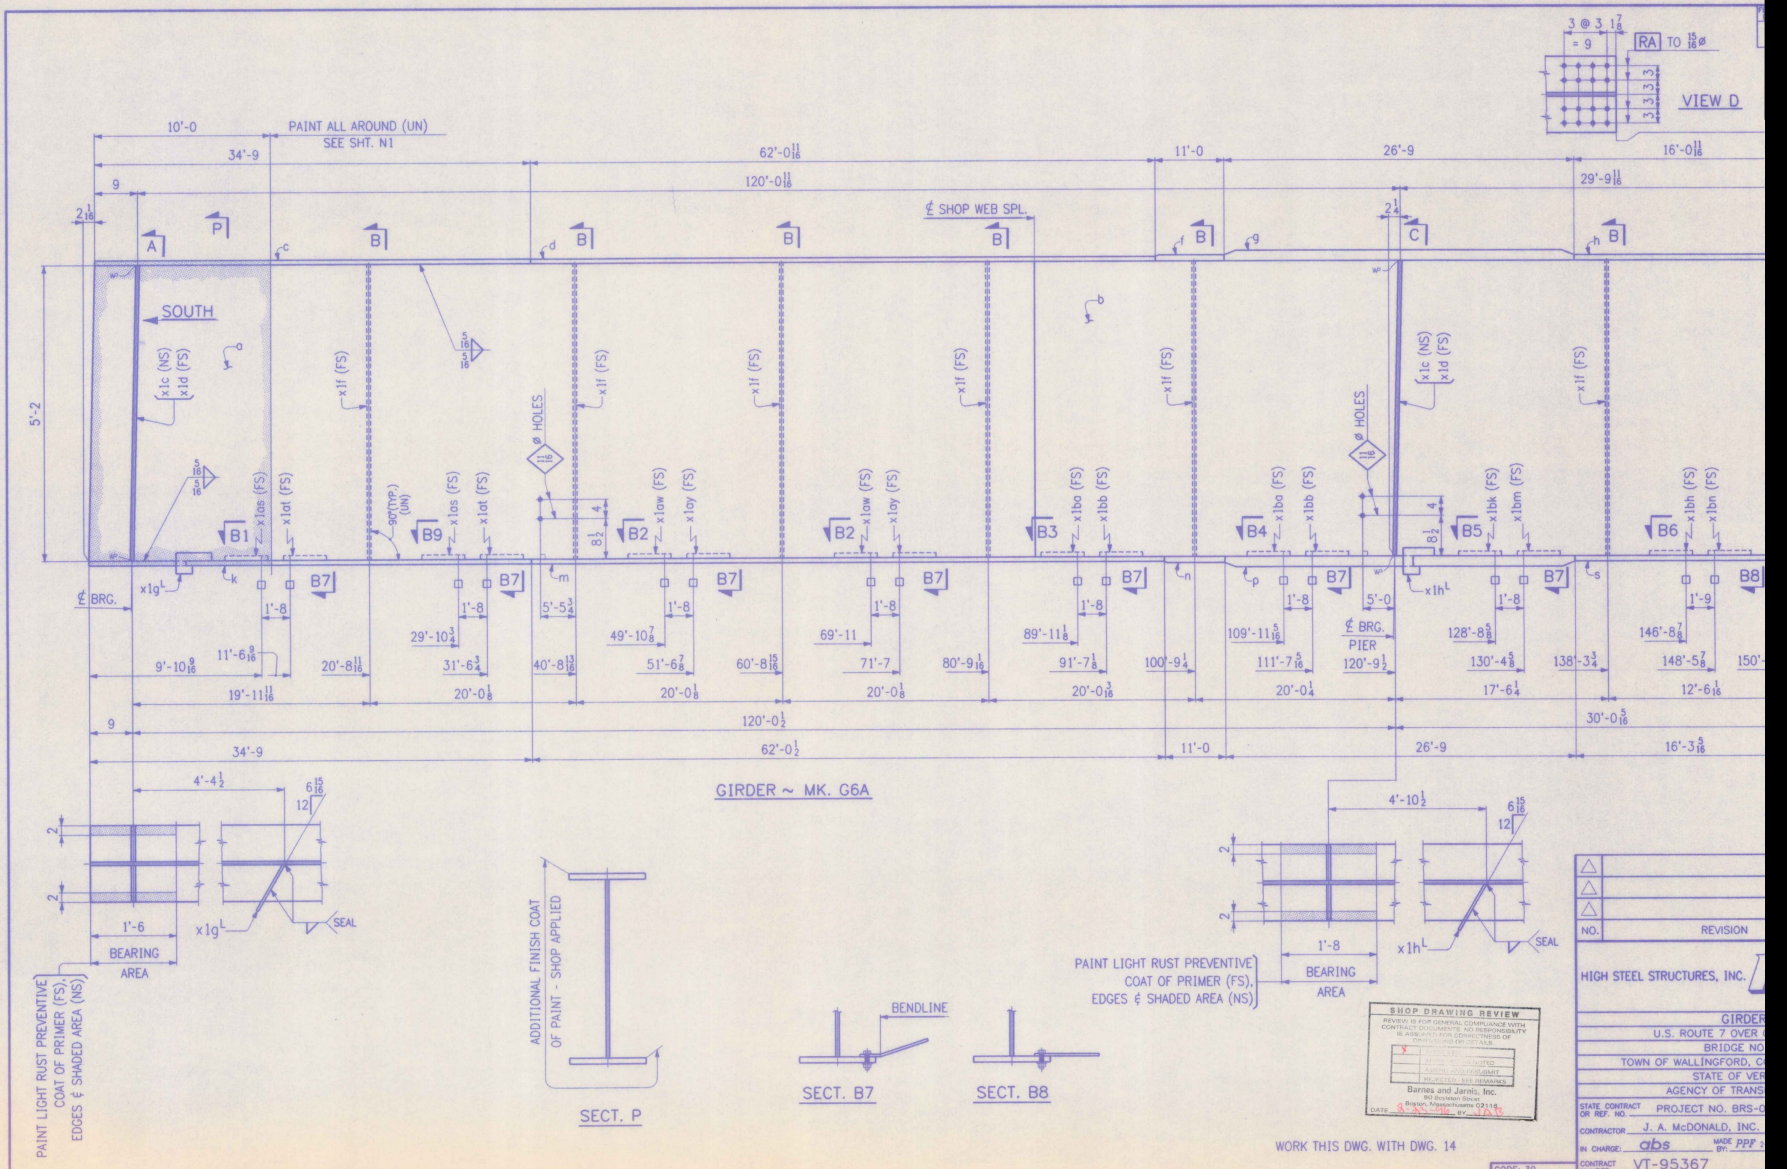

VIEW D
PAINT ALL AROUND (UN) SEE SHT. N1
SOUTH
℄ SHOP WEB SPL.
℄ BRG. PIER
GIRDER ~ MK. G6A
SECT. P
SECT. B7
SECT. B8
BENDLINE
ADDITIONAL FINISH COAT OF PAINT - SHOP APPLIED
PAINT LIGHT RUST PREVENTIVE COAT OF PRIMER (FS), EDGES & SHADED AREA (NS)
BEARING AREA
SEAL
WORK THIS DWG. WITH DWG. 14
SHOP DRAWING REVIEW
Barnes and Jarnis, Inc.
HIGH STEEL STRUCTURES, INC.
REVISION
GIRDER
U.S. ROUTE 7 OVER
BRIDGE NO.
TOWN OF WALLINGFORD, C
STATE OF VER
AGENCY OF TRANS
STATE CONTRACT OR REF. NO. PROJECT NO. BRS-0
CONTRACTOR J. A. McDONALD, INC.
IN CHARGE: abs
MADE BY: PPP
CONTRACT NUMBER VT-95367
CODE: 30