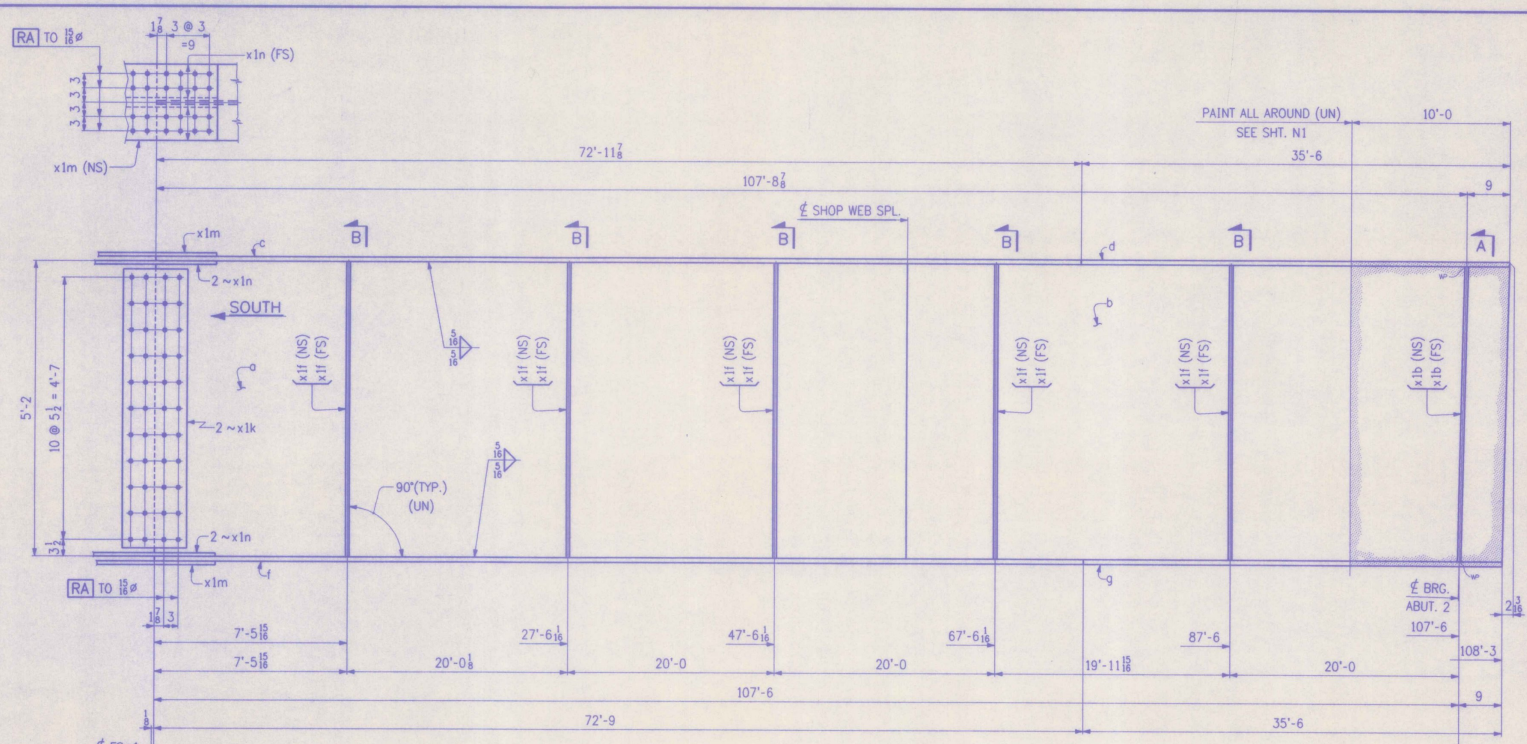


BILL OF MA

NO.	MARK	DESCRIPTION	LENGTH	
ONE	G4B	GIRDER		
1	a	PL 62 x 5/8	65	6 1/16
1	b	PL 62 x 5/8	42	11 5/8
1	c	PL 16 x 1 1/8	72	11
1	d	PL 16 x 1 1/8	35	6
1	f	PL 16 x 1 1/8	72	9
1	g	PL 16 x 1 1/8	35	6
2	x1k	PL 58 x 5/16	1	1
2	x1m	PL 16 x 5/8	2	1
4	x1n	BAR 7 x 3/4	2	1
2	x1b	BAR 7 1/2 x 5/8	5	2
10	x1f	BAR 7 1/2 x 1/2	5	2

SHOP DRAWING
REVIEW IS FOR GENERAL CONFORMANCE WITH DESIGN CONCEPT AND GENERAL COMPLIANCE WITH CONTRACT DOCUMENTS. THIS REVIEW DOES NOT RELIEVE THE CONTRACTOR OF RESPONSIBILITY TO ADHERE TO CONTRACT PLANS AND SPECIFICATIONS AND TO COORDINATE AND CHECK ALL DIMENSIONS AND QUANTITIES. CONTRACTOR IS RESPONSIBLE FOR CONFIRMING AND CORRELATING ALL QUANTITIES AND DIMENSIONS, FABRICATION PROCESSES AND TECHNIQUES OF CONSTRUCTION, COORDINATION OF HIS WORK WITH THAT OF ALL OTHER TRADES AND THE SATISFACTORY PERFORMANCE OF HIS WORK.
APPROVED
APPROVED AS NOTED
AMEND AND RESUBMIT
RESUBMIT
Barnes and Jarois
80 Boylston Street
Boston, Massachusetts
DATE 3-23-95 BY

NO.	REVISION
△	
△	
△	

HIGH STEEL STRUCTURES, INC.

GIRDE
U.S. ROUTE 7 OVER
BRIDGE N
TOWN OF WALLINGFORD,
STATE OF V
AGENCY OF TRAN

STATE CONTRACT OR REF. NO. PROJECT NO. BRS-
CONTRACTOR J. A. McDONALD, INC
IN CHARGE: abs MADE BY: ppp
CONTRACT NUMBER: VT-95367

SHOP NOTE
HOLES: 15/16ø (UN)
BOLTS: AS NOTED
PAINT: AS NOTED, SEE DWG. N1
FOR GENERAL SHOP NOTES, SEE DWG. N1.
FOR WEB CAMBER DIAGRAM, SEE DWG. WC1.

CODE: 30

400-9