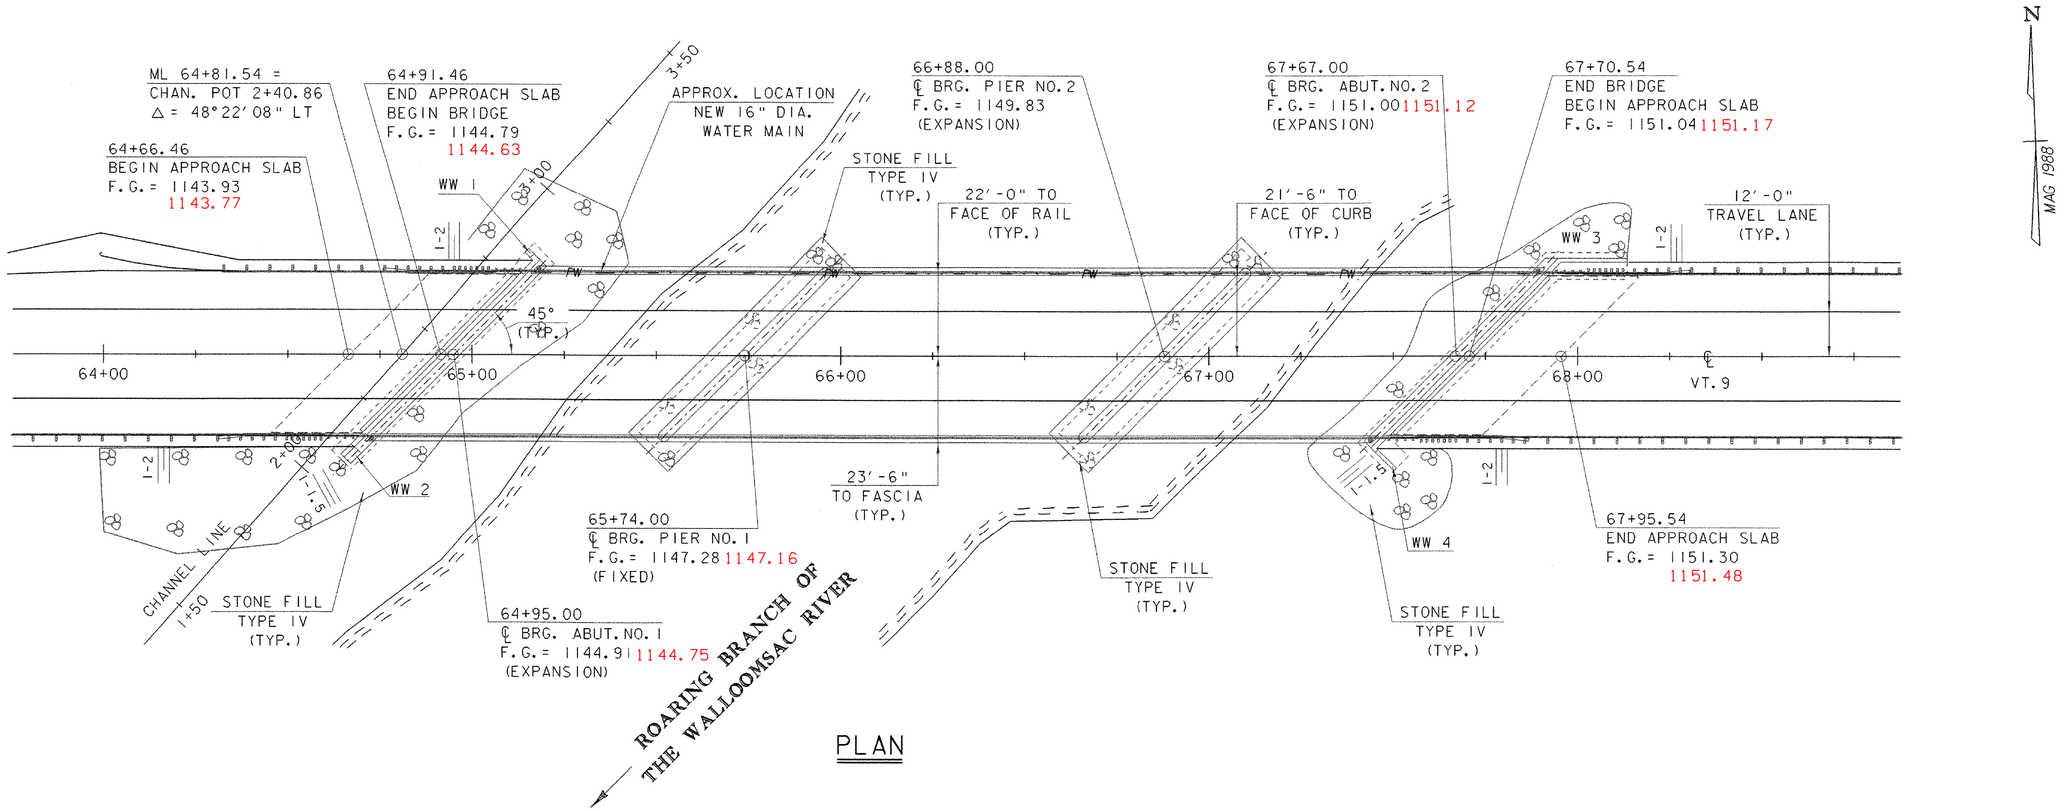

PLAN

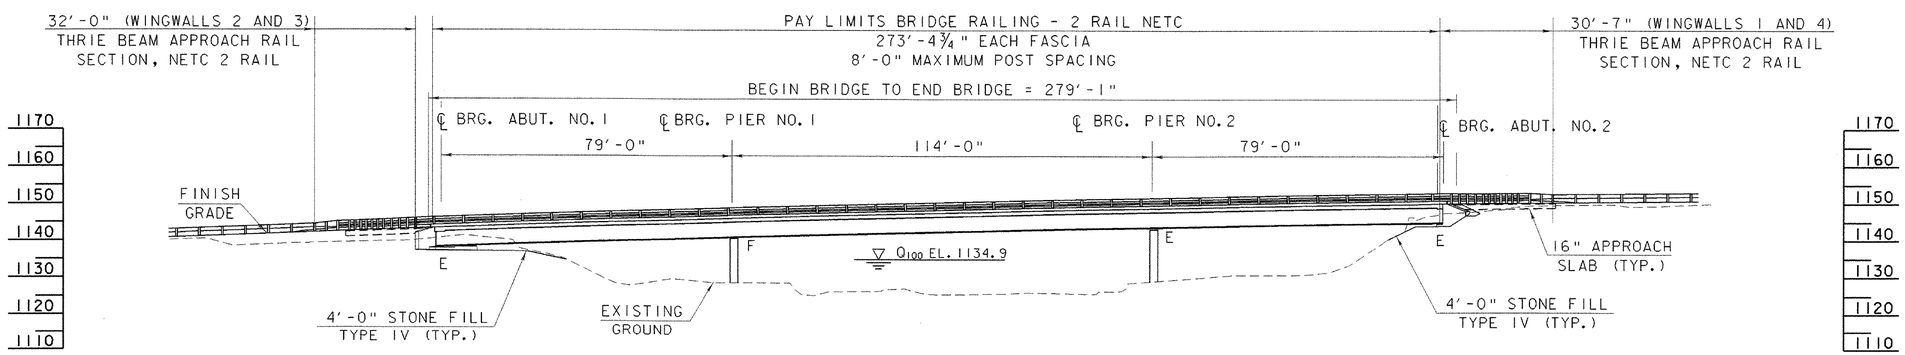

ELEVATION

0 20 40
SCALE IN FEET

PLAN AND ELEVATION SHEET

PROJECT: WOODFORD	PROJECT NO.: BHF 010-1(29)
DESIGN FILE NAME: /84e039/structures/se039pe.dgn	
IPARM FILE NAME: se039pe.I	PLOT DATE: 03-OCT-2005
SURVEYED BY: MOREAU	SURVEY DATE: 12-88
SQUAD LEADER: PORTALUPI	DRAWN BY: EVANS-MONGEON
PLAN AND ELEVATION	SHEET: 48 OF 106

DATUM

VERTICAL	NGVD 1929
HORIZONTAL	N/A