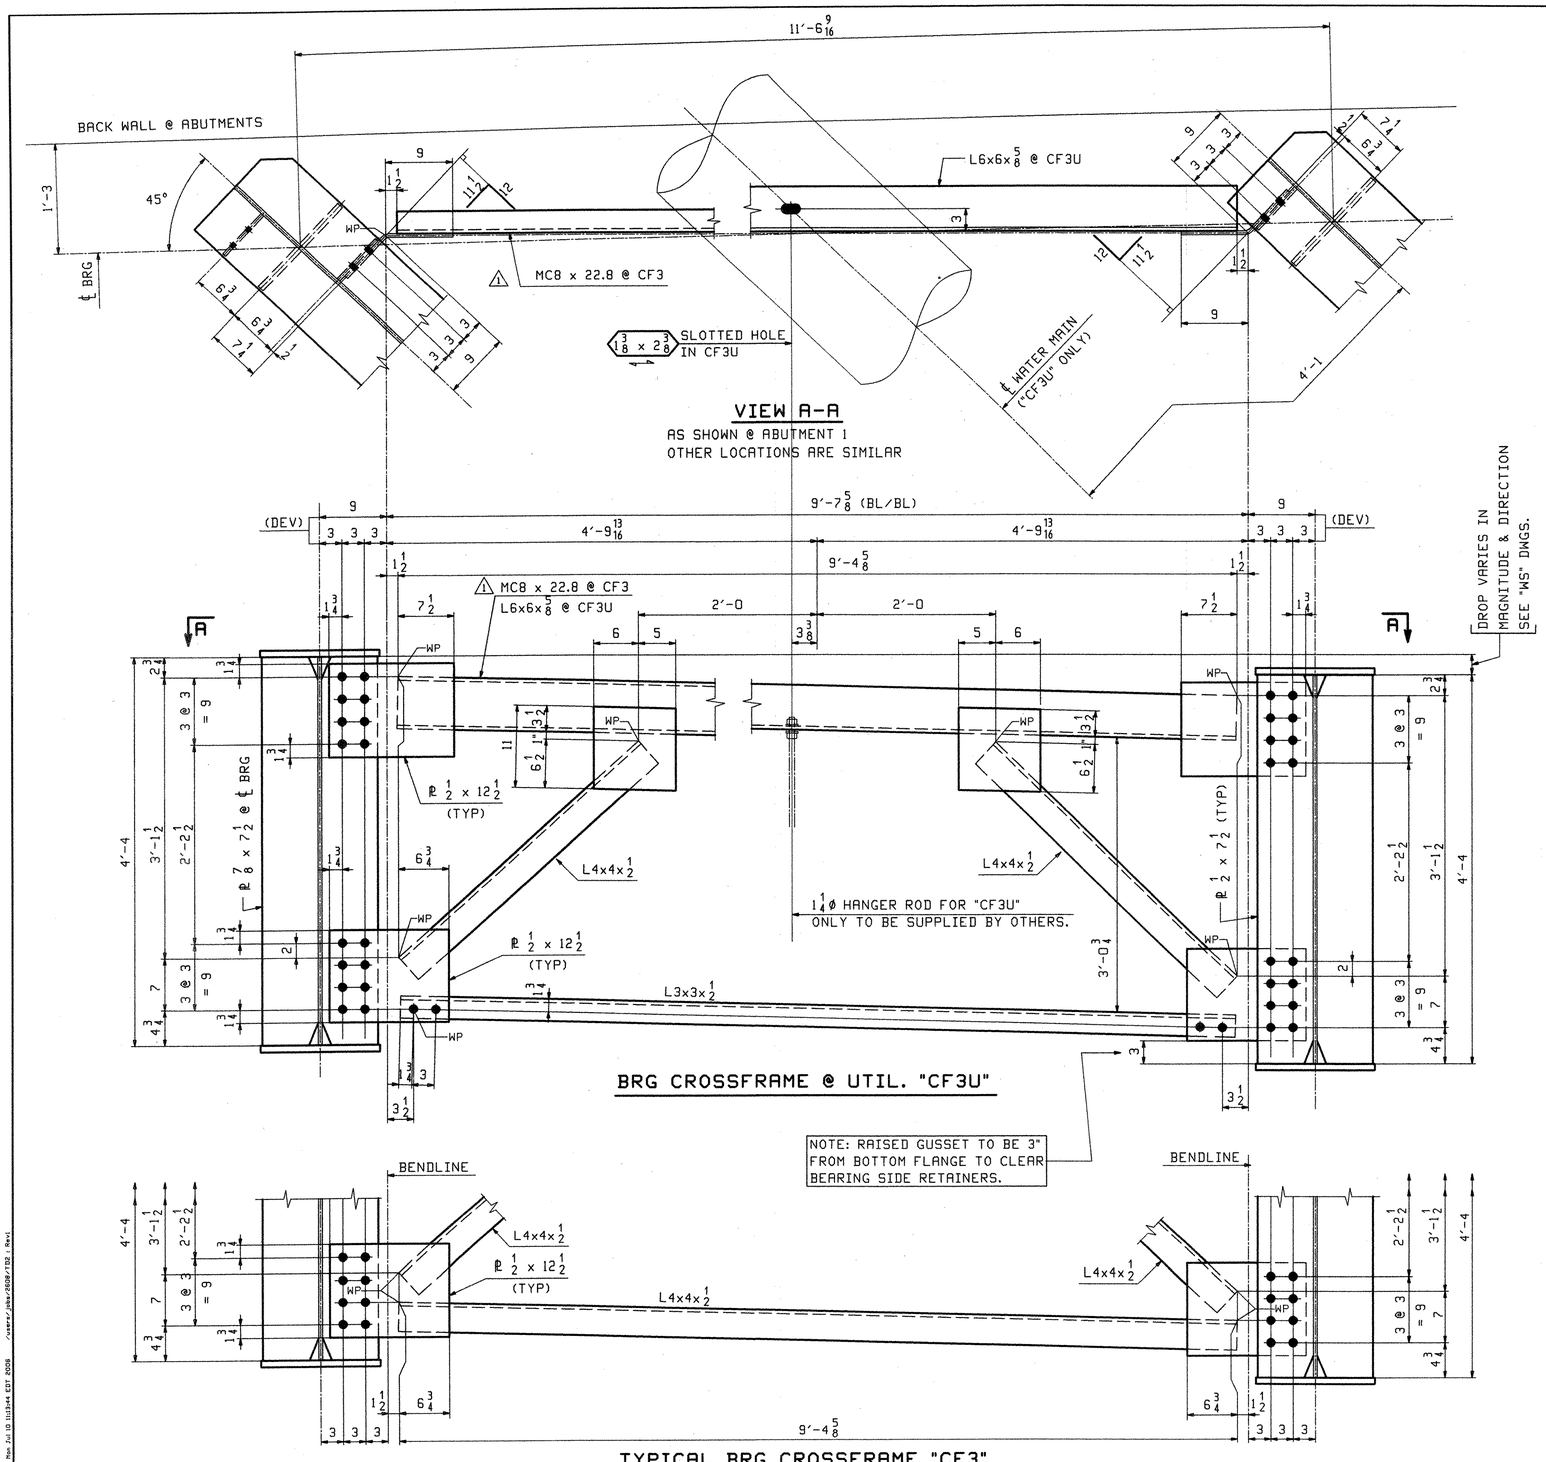

**** NOTE ****
THE PURPOSE OF THIS DRAWING IS TO COORDINATE GEOMETRIC CONTROL INFORMATION AND CONNECTION SPACING. THIS DWG IS SUBMITTED FOR INFORMATION ONLY & IS NOT INTENDED FOR SHOP FABRICATION. DETAIL DWGS WILL SHOW ALL WELDING AND DIMENSIONS REQ'D FOR FABRICATION.

REV.	REMARKS	DATE	DWN	CHK	APP	Q.A.	NO.	DIA.	LGT	TYPE	WASHER
	OUT FOR APPROVAL	7-17-06									
	OUT FOR APPROVAL										
	ISSUED TO SHOP										
	FIELD & OFFICE										
1	MC8 x 22.8 @ CF3	07/10	WL	PCP							

MATERIAL: M270-50W (UN)
ELECTRODES:
HOLES: 15/16"ø (UN)
SHOP BOLTS:
SURFACE PREP. & PAINT:

RECEIVED
CK'D BY ____ CK'D BY MAM
JUL 26 2006
RESUBMIT ____ APPROVED ✓
BY DATE 7/28/06

DESCRIPTION: END CROSSFRAME LAYOUTS
JOB: RTE 9 OVER ROARING BRANCH OF WALLOOMSAC RIVER
BRIDGE No. BR 11
WOODFORD, VT. BENNINGTON COUNTY
TENSOR 2608
PROJ NO. BHF 010-1(29)
CUSTOMER: RENAUD BROTHERS, INC.

	DRAWN BY	DATE
	WL	02/07
	CHKD BY	
	PCP	02/22
	APPROV BY	
	SUPERVISOR	W. J. GATTI
	Q.A.	

CASCO BAY STEEL STRUCTURES, INC.
75 SPRING HILL ROAD SACO, MAINE 04072
PHONE (207) 282-7360 FAX. (207) 282-1179

JOB NO.	DRG. NO.
290	TD2
	REV. 1

WL Mon Jul 10 11:34:44 EDT 2006 /users/jobs/2608/TD2.Rev1