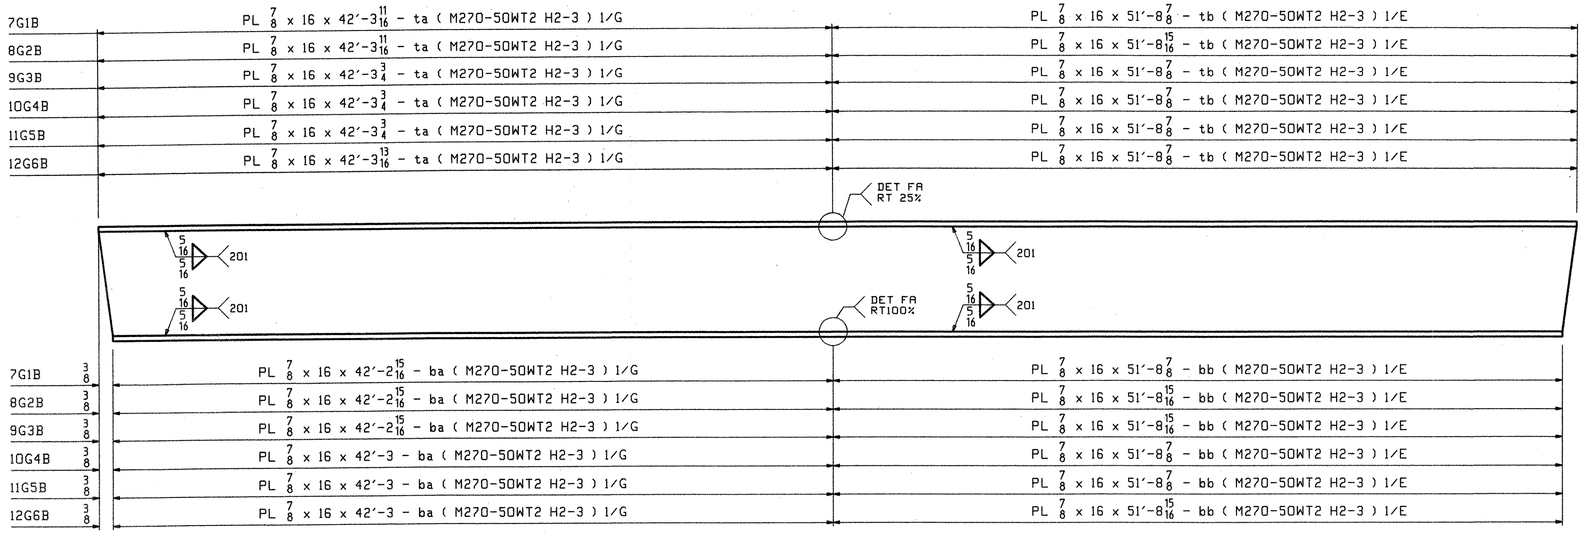

FLANGE DIAGRAM FOR 7G1B THRU 12G6B

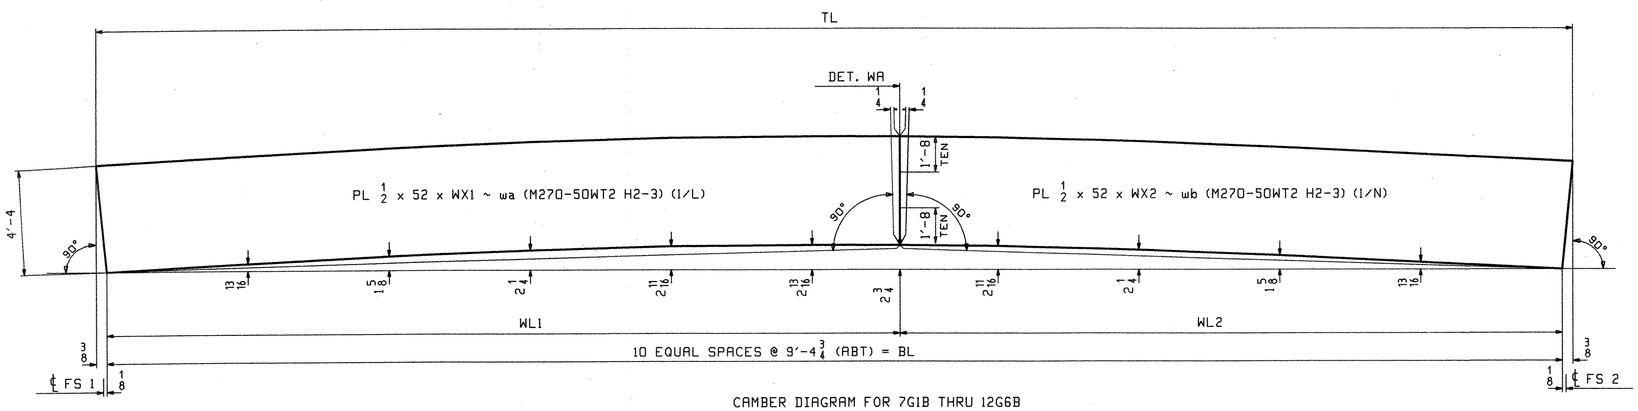

CAMBER DIAGRAM FOR 7G1B THRU 12G6B

MARK	TL	BL	WL1	WL2	WX1	WX2
7G1B	94'-0 9/16	93'-11 13/16	49'-5 7/8	44'-5 15/16	49'-6 1/4	44'-6 5/16
8G2B	94'-0 5/8	93'-11 7/8	49'-5 7/8	44'-6	49'-6 1/4	44'-6 3/8
9G3B	94'-0 5/8	93'-11 7/8	49'-5 7/8	44'-6	49'-6 1/4	44'-6 3/8
10G4B	94'-0 5/8	93'-11 7/8	49'-5 7/8	44'-6	49'-6 1/4	44'-6 3/8
11G5B	94'-0 5/8	93'-11 7/8	49'-5 7/8	44'-6	49'-6 1/4	44'-6 3/8
12G6B	94'-0 11/16	93'-11 15/16	49'-5 7/8	44'-6 1/16	49'-6 1/4	44'-6 7/16

NOTES:
1. ALL MATERIAL IS M270-50WT2 (CVN).
2. FOR GENERAL NOTES AND DETAILS "FA" & "WA" SEE DWG GN1.

REV.	REMARKS	DATE	DWN	CHK	APP	Q.A.	NO.	DIA.	LGT	TYPE	WASHER
OUT FOR APPROVAL		FINAL 7-17-06									
OUT FOR APPROVAL											
ISSUED TO SHOP											
FIELD & OFFICE											

MATERIAL: | ELECTRODES: | HOLES: | SHOP BOLTS:

SURFACE PREP. & PAINT:

DESCRIPTION: BASIC GIRDER

JOB: RTE 9 OVER ROARING BRANCH OF WALLOOMSAC RIVER
BRIDGE No. BR 11
WOODFORD, VT. BENNINGTON COUNTY

TENSOR 2608

PROJ NO. BHF 010-1(29)

CUSTOMER: RENAUD BROTHERS, INC.

DRAWN BY	DATE
WL	02/17
CHKD BY	
PCP	02/22
APPROV BY	
SUPERVISOR	W. J. GATTI
Q.A.	

RECEIVED
CK'D BY ____ CK'D BY Mem
JUL 26 2006
RESUBMIT ____ APPROVED ✓
BY ____ DATE 7/28/06

CASCO BAY STEEL STRUCTURES, INC.
75 SPRING HILL ROAD SACO, MAINE 04072
PHONE (207) 282-7360 FAX. (207) 282-1179

JOB NO.	DRG. NO.
290	C2
	REV. △

121 SS