ABM INFO		SHIP	BILL OF MATERIAL					JOB NO. 290	DRAWING NO. 8	REV.
PAGE	LINE	MARK	QTY	MARK	MATERIAL	LENGTH FT	LENGTH INCHES	REMARKS	WT	PROCUREMENT NOTES
		8G2B	1		GIRDER				18385	
1	L		1	wa	PL $\frac{1}{2}$x52	49	$6\frac{1}{4}$	(M270-50WT2) (H2-3)		
1	N		1	wb	PL $\frac{1}{2}$x52	44	$6\frac{3}{8}$	(M270-50WT2) (H2-3)		
1	G		1	ta	PL $\frac{7}{8}$x16	42	$3\frac{11}{16}$	(M270-50WT2) (H2-3)		
1	E		1	tb	PL $\frac{7}{8}$x16	51	$8\frac{15}{16}$	(M270-50WT2) (H2-3)		
1	G		1	ba	PL $\frac{7}{8}$x16	42	$2\frac{15}{16}$	(M270-50WT2) (H2-3)		
1	E		1	bb	PL $\frac{7}{8}$x16	51	$8\frac{15}{16}$	(M270-50WT2) (H2-3)		
2	J		7	x2c	PL $\frac{1}{2}$x$7\frac{1}{2}$	4	4			
2	J		7	x2d	PL $\frac{1}{2}$x$7\frac{1}{2}$	4	4			
2	J		6	x2f	PL $\frac{1}{2}$x$7\frac{1}{2}$	4	4			

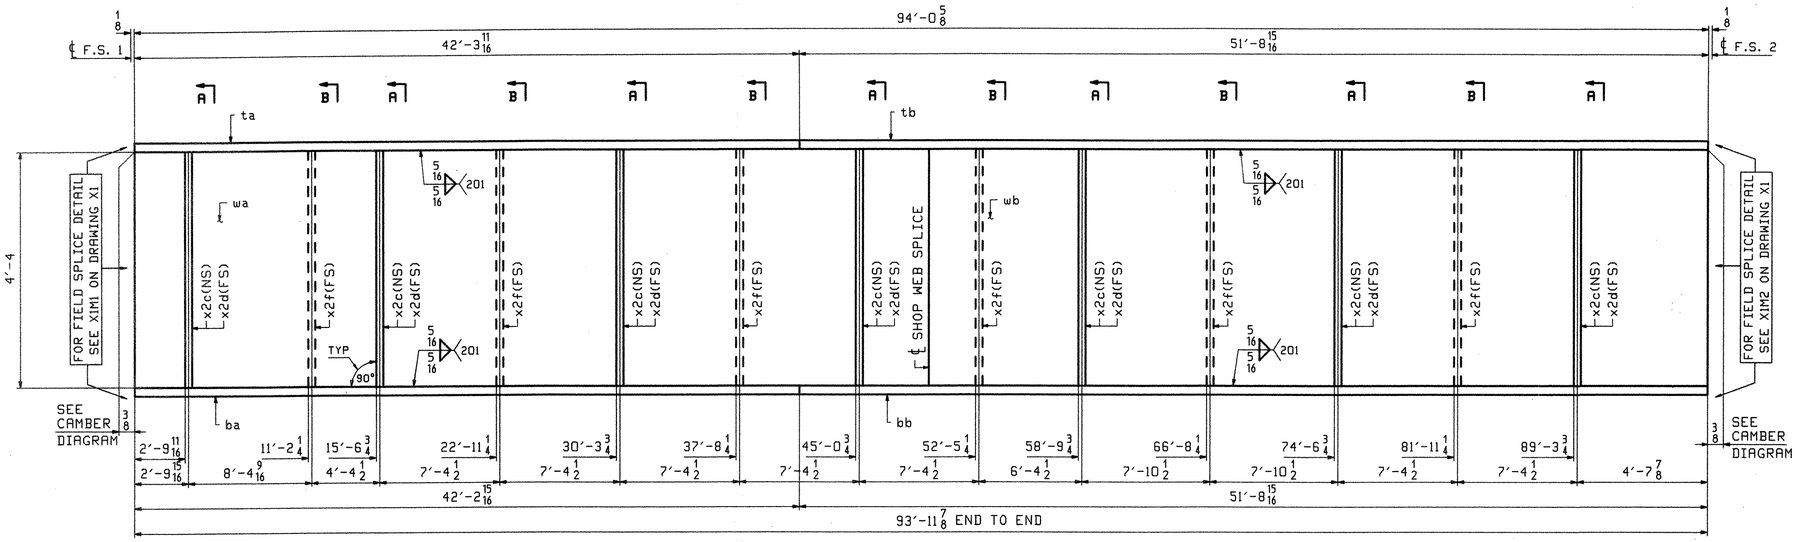

ONE - GIRDER - 8G2B

FOR FIELD SPLICE DETAILS SEE DRAWING X1.
FOR GIRDER STANDARD DETAILS SEE DRAWING X2.
FOR CAMBER & FLANGE DIAGRAMS SEE DRAWING C2.
FOR GENERAL NOTES SEE DRAWING GN1.
H2-3 DENOTES MATERIAL SUBJECT TO CHARPY V-NOTCH TESTING.

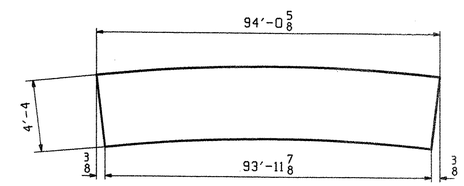

ORIENTATION DIAGRAM
FOR CAMBER SEE DRAWING C2

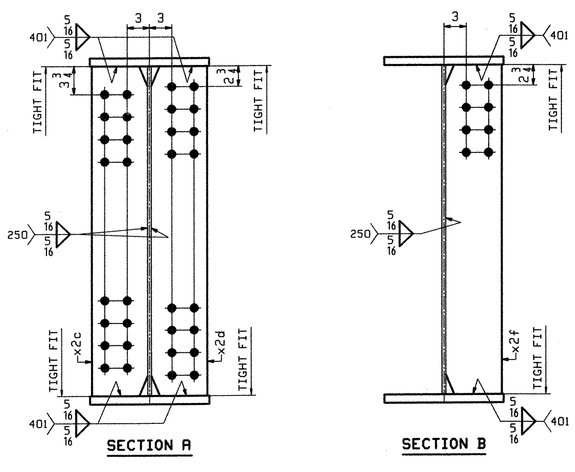

OUT FOR APPROVAL	Email 7-17-06									
OUT FOR APPROVAL										
ISSUED TO SHOP										
FIELD & OFFICE										
REV.	REMARKS	DATE	DWN	CHK	APP	Q.A.	NO.	DIA.	LGT	TYPE	WASHER

MATERIAL: M270-50W (UN)
ELECTRODES:
HOLES: $\frac{15}{16}$"Ø
SHOP BOLTS: NONE
SURFACE PREP. & PAINT: SEE DRAWING GN1

RECEIVED
CK'D BY ____ OK'D BY MGM
JUL 26 2006
RESUBMIT ____ APPROVED ✓
BY DATE 7/28/06

DESCRIPTION: GIRDER - 8G2B
JOB: RTE 9 OVER ROARING BRANCH OF WALLOOMSAC RIVER
BRIDGE No. BR 11
WOODFORD, VT. BENNINGTON COUNTY

DRAWN BY	DATE
JTB	02/22
CHKD BY	
PCP	03/06
APPROV BY	
SUPERVISOR	W. J. GATTI
Q.A.	

TENSOR 2608

PROJ NO. BHF 010-1(29)
CUSTOMER: RENAUD BROTHERS, INC.

CASCO BAY STEEL STRUCTURES, INC.
75 SPRING HILL ROAD SACO, MAINE 04072
PHONE (207) 282-7360 FAX. (207) 282-1179

JOB NO.	DRG. NO.
290	8
	REV. △

PCP Tue Mar 14 11:24:32 EST 2006 /users/jobs/2608/8 : Rev0