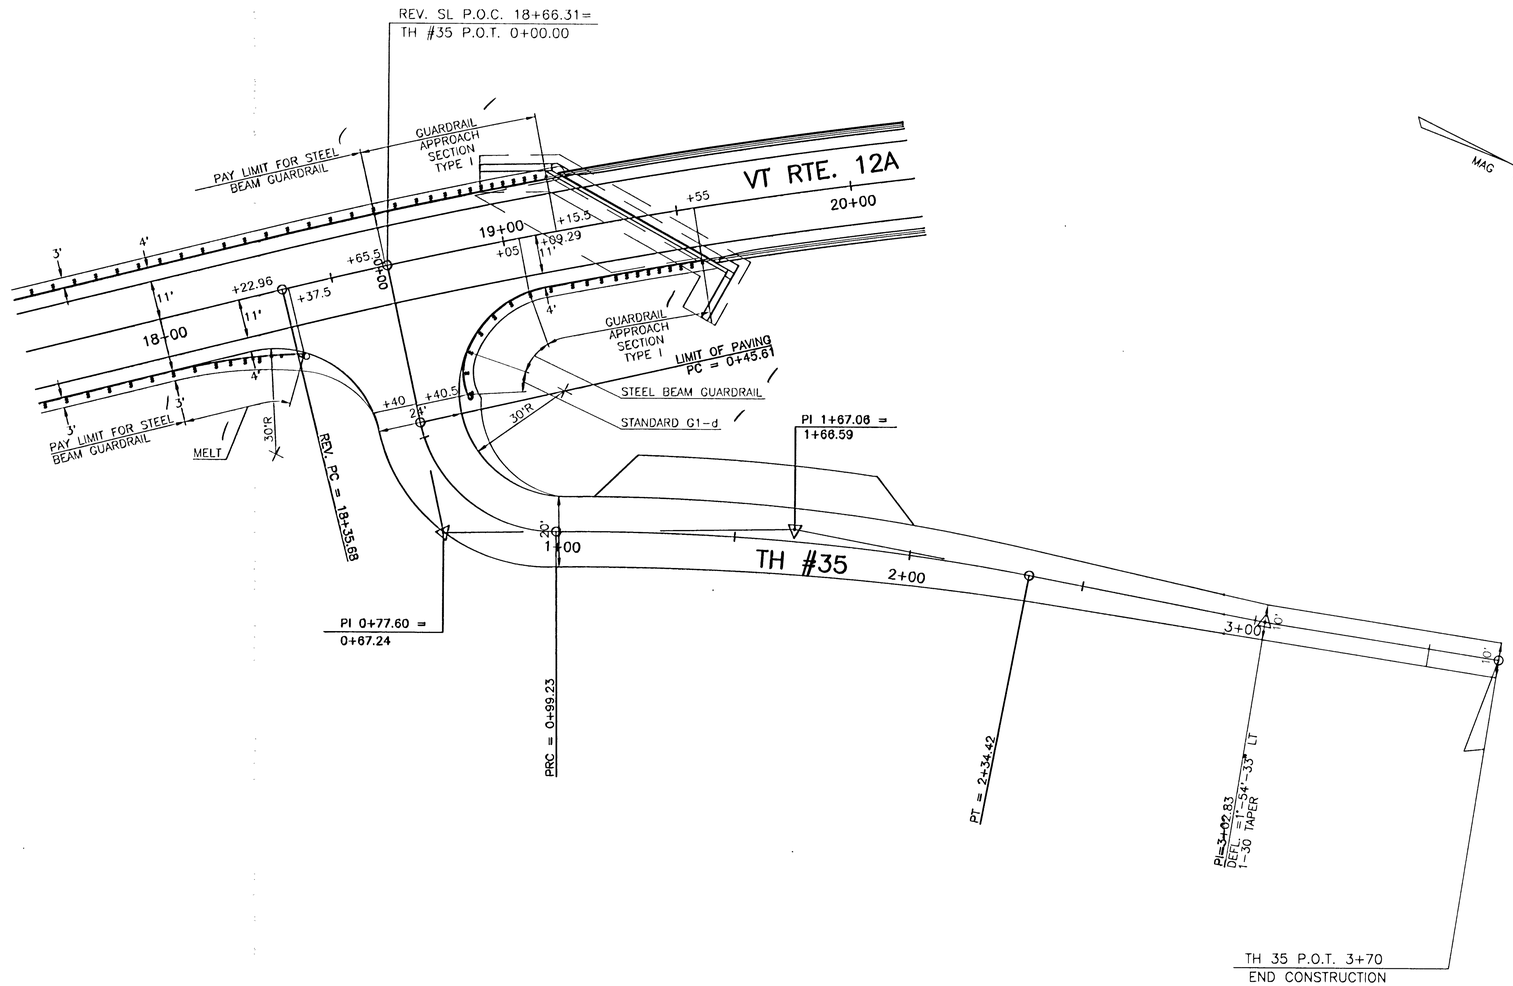

PAVEMENT & GUARDRAIL TRANSITIONS

SCALE IN FEET
0 10 20 40

PLAN		BY	DATE
	SURVEYED		
	PLOTTED		
NOTE BOOK	ALIGNMENT CHECKED		
NO.	RT. OF WAY CHECKED		

PROFILE		BY	DATE
	SURVEYED		
	PLOTTED		
NOTE BOOK	GRADES CHECKED		
NO.	BY		
	TURE NOTATNS CHKD		

DATUM

VERTICAL NGVD 1929

HORIZONTAL N/A

STATE OF VERMONT
AGENCY OF TRANSPORTATION

Town Of BRAINTREE		Bridge No. 6
Highway No. VT. Route 12A		Log Sta.
		Surv. Sta.
VT RTE 12A OVER THE THIRD BRANCH OF THE WHITE RIVER		
PAVEMENT AND GUARDRAIL TRANSITION SHEET		
Designed By J. Warner		Drawn By. N. Spaulding
Checked By J. Warner	Date 9/94	Bridge Design Supervisor Date
PROJECT BRAINTREE		PROJECT NO. BRS 0187(6)
I.G.C. Info.		
Bridge Sheet No.		Sheet 19 Of 79

90282-CR DWG