PAVEMENT MARKINGS

DURABLE 4" DOUBLE YELLOW LINE
(WITH BREAKS FOR TOWN HIGHWAY 35)
STA 11+50 TO STA 26+00 (CENTER LINE)

DURABLE 4" WHITE LINE
STA 11+50 TO STA 0+45 RT.(TH 35)
STA 11+50 TO STA 26+00 LT
STA 0+45 LT.(TH 35) TO STA 26+00 RT

TEMPORARY 4" DOUBLE YELLOW LINE
(WITH BREAKS FOR TOWN HIGHWAY 35)
STA 11+50 TO STA 26+00 (CENTER LINE)

TEMPORARY 4" WHITE LINE
AS DIRECTED BY ENGINEER

DURABLE 24" STOP BAR
STA 0+22 LT. (TH 35)

REMOVING SIGNS
17 EACH

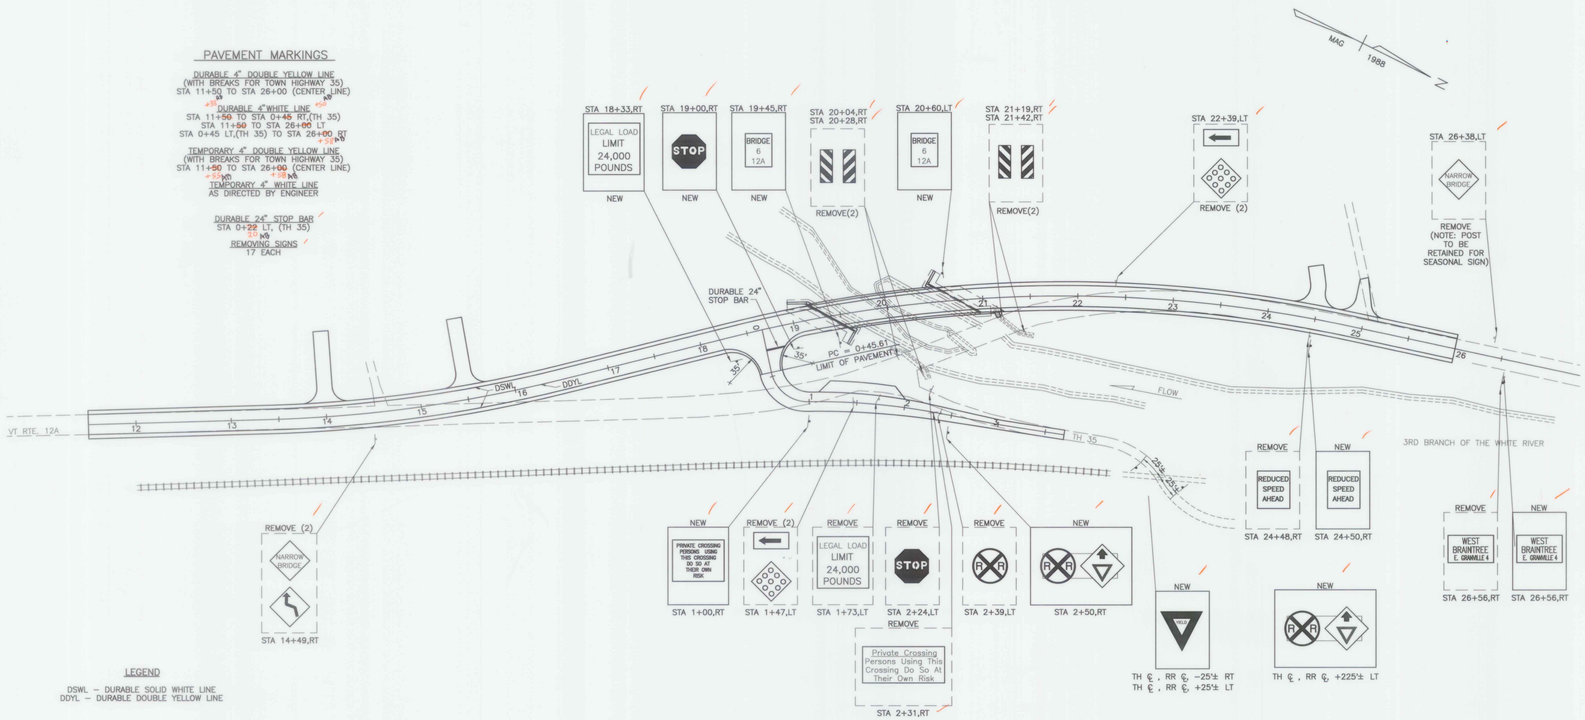

LEGEND

DSWL – DURABLE SOLID WHITE LINE
DDYL – DURABLE DOUBLE YELLOW LINE

PLAN	BY	DATE
NOTE BOOK NO.	SURVEYED	
	DRAWN	
	CHECKED	
	PLAN CHECKED	
	R.O.W. MAP	
	CHECKED	

STATE OF VERMONT
AGENCY OF TRANSPORTATION

Town Of BRAINTREE	Bridge No. 6
Highway No. VT. Route 12A	Log Sta.
	Surv. Sta.
VT RTE 12A OVER THE THIRD BRANCH OF THE WHITE RIVER	
TRAFFIC SIGN AND PAVEMENT MARKING PLAN	
Designed By	Drawn By.
Checked By Date J. Warner 9/94	Bridge Design Supervisor Date
PROJECT BRAINTREE	PROJECT NO. BRS 0187(6)
I.G.C. Info.	
Bridge Sheet No.	Sheet 21 Of 79

92092-PL.DWG