TRAFFIC SIGN SUMMARY SHEET

TRAFFIC SIGN SUMMARY AND DETAIL SHEET

MILEMARKER, STATION, OR SIGN NUMBER	SIGN LEGEND	SIGN DIMENSIONS	NEW AND SALVAGED SIGNS				EXISTING POSTS				NEW SIGN POSTS																	REMARKS	SIGN	DETAIL
			"A"	"B"	SALV. SIGN	SALV. T.I.S.	RET.	DRILL	REM.	SALV.	NO. OF POSTS	FLANGED CHANNEL LB./FT. 1.12	2.0	2.5	3.0	TUBULAR ALUMINUM 3.0"ø	4.0"ø	TUBULAR STEEL FOUNDATION	3"ø	3.5"ø	4.0"ø	5.0"ø	W SHAPED STEEL POST SIZE	WEIGHT	FTG. SIZE 24"	30"	SIGN FRAME		PLAN SHEET NUMBER	STD. SHEET NUMBER
STA 18+33 RT	LEGAL LOAD LIMIT 24,000 POUNDS	24"x 30"	5.00								1				14 X														–	E-141
STA 19+00 RT	STOP	30"x 30"	6.25								1				14 X														–	E-143
STA 19+45 RT	BRIDGE 6 12A	6"x 8"	0.33								1				8 X														–	E-134
STA 20+60 LT	BRIDGE 6 12A	6"x 8"	0.33								1				8 X														–	E-134
STA 24+50 RT	REDUCED SPEED AHEAD	24"x 30"	5.00								1				14 X														–	E-142
STA 26+56 RT	WEST BRAINTREE E GRANVILLE 4	30"x 18"	3.75								1				14 X														–	E-128A E-128B
STA 1+00 RT	PRIVATE CROSSING PERSONS USING THIS CROSSING DO SO AT THEIR OWN RISK	30"x 24"	5.00								1				14 X														–	–
STA 2+50 RT	RR	18" R 36"X 36"	7.07 9.00								2				14 X 14													WITH ASSEMBLY FRAME	–	E-190 E-150 E-123
TH 35 & RR ℄ INT, -25'± RT	YIELD	36"X 36"X 36"	3.90								1				14 X														–	E-146
TH 35 & RR ℄ INT +25'± LT	YIELD	36"X 36"X 36"	3.90								1				14 X														–	E-146
TH 35 & RR ℄ INT +225'± LT	RR	18" R 36"X 36"	7.07 9.00								2				14 X 14													WITH ASSEMBLY FRAME	–	E-190 E-150 E-123
FINAL POST LENGTHS ARE TO BE DETERMINED IN THE FIELD. POST SIZES ARE COMPUTED BASED ON INFORMATION FURNISHED ON THE STANDARD SHEETS AND THE DESIGN DIVISION'S " SIGN POST DESIGN MANUAL ". TOTALS			SF. 65.60	SF.	EA.	SF.									510 ~~597~~ 510 RD			EA.					LBS.		EA.	EA.					

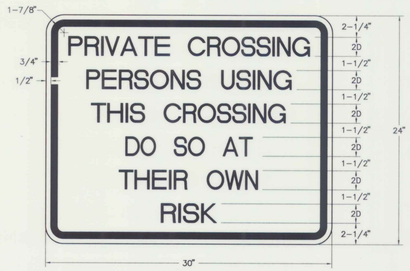

SEE STD. E-150 FOR COLORS AND MATERIALS

TEXT LAYOUT DIMENSIONS ARE BASED ON THE "LETTER AND NUMERAL WIDTHS AND SPACE" TABLES FOUND IN THE "STANDARD HIGHWAY SIGNS" BOOKLET. MINOR VARIATIONS IN TEXT DIMENSIONS ARE ACCEPTABLE BASED ON INDIVIDUAL MANUFACTURER'S LETTER FABRICATION. SIGNIFICANT CHANGES WHICH AFFECT SIGN APPEARANCE SHALL BE BROUGHT TO THE ATTENTION OF THE VAOT'S TRAFFIC AND SAFETY DIVISION BEFORE FABRICATION.

PREPARED BY NLS DATE 3/92
CHECKED BY JAW DATE 1/95
DESIGN SUPERVISOR _____ DATE _____
PROJ. BRAINTREE BRS 0187(6)
TRAFFIC SHEET NO. ____ OF ____
SHEET 22 OF 79 SHEETS

SIGNS