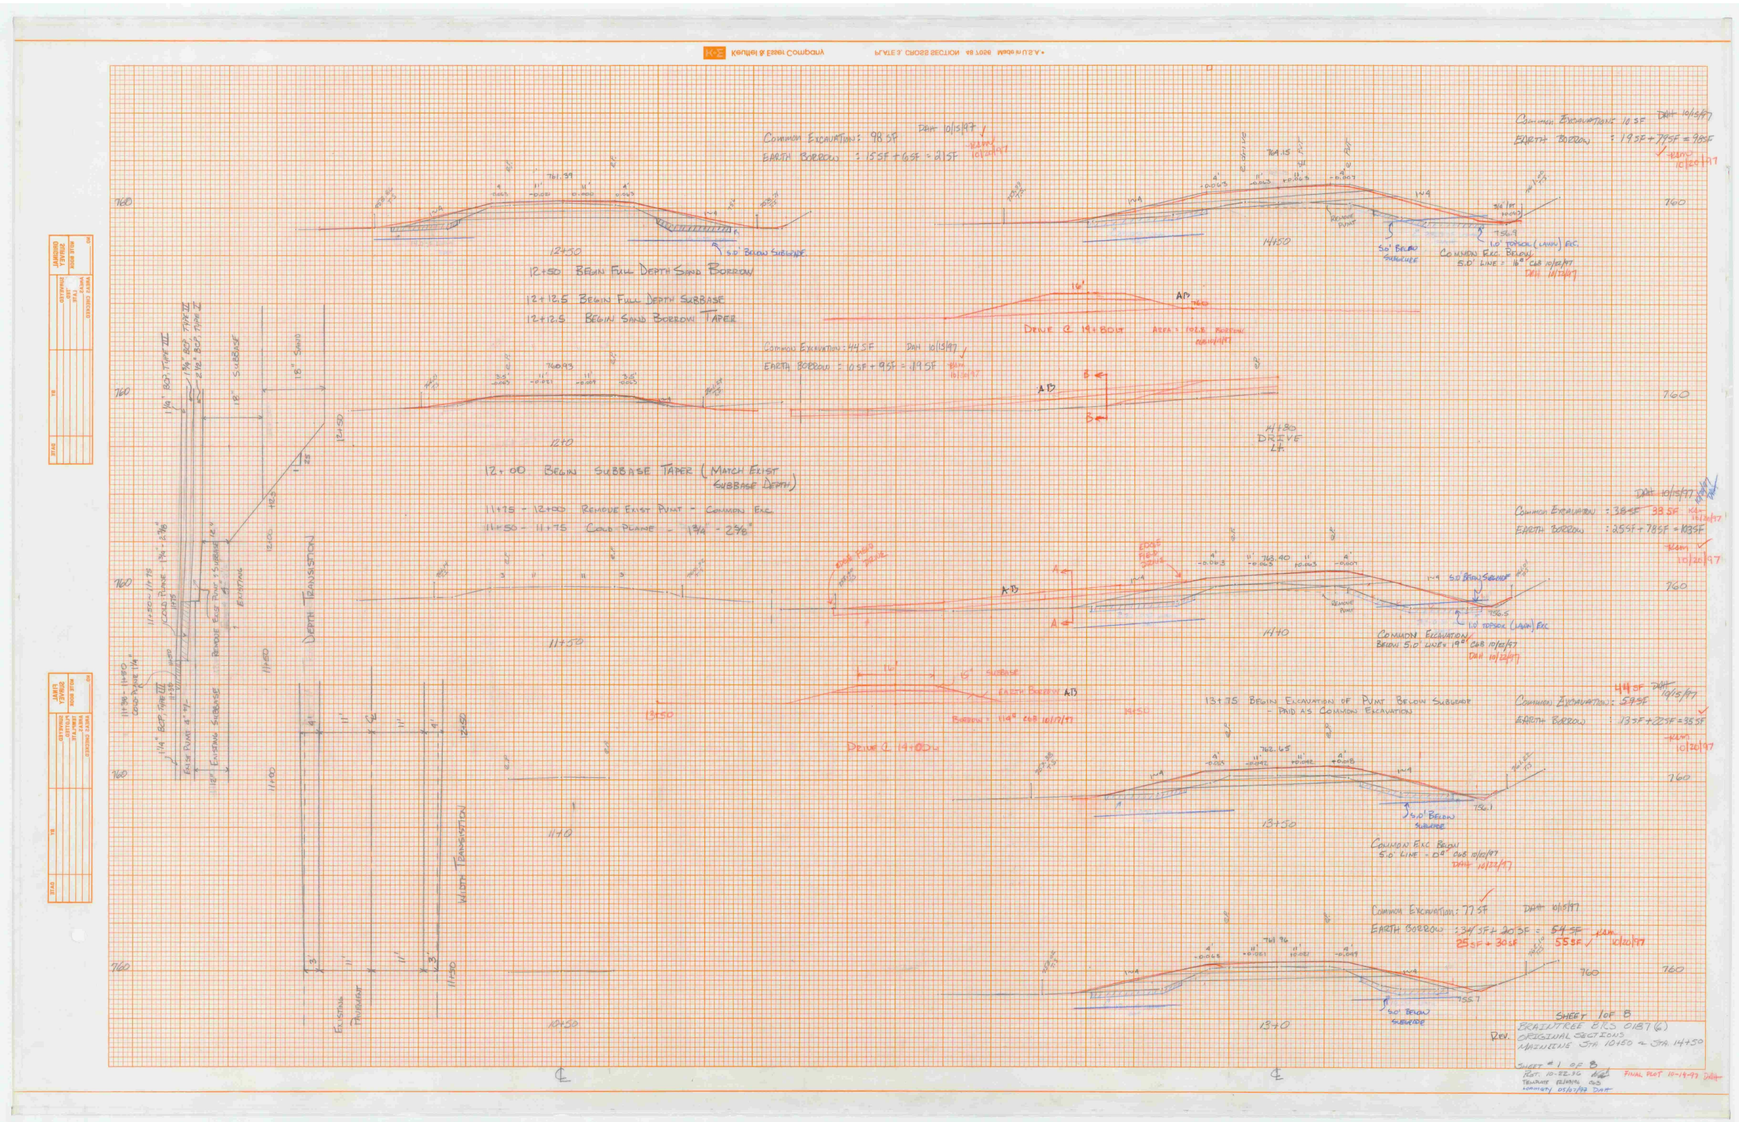
Common Excavation: 98 SF
Earth Borrow: 15SF + 6SF = 21SF
Common Excavation: 16SF
Earth Borrow: 19SF + 7SF = 26SF
12+12.5 Begin Full Depth Subbase
12+12.5 Begin Sand Borrow Taper
Drive @ 14+00
Common Excavation: 44SF
Earth Borrow: 10SF + 9SF = 19SF
12+00 Begin Subbase Taper (Match Exist Subbase Depth)
11+75 - 12+00 Remove Exist Pvmt - Common Exc.
11+50 - 11+75 Cold Plane - 1 3/4" - 2 3/4"
Depth Transition
Common Excavation
Below 5.0' Line: 19" CAB 10/10/97
13+75 Begin Excavation of Pvmt Below Subgrade - Paid as Common Excavation
Common Excavation: 59SF
Earth Borrow: 13SF + 22SF = 35SF
Common Exc Below 5.0' Line - 12" CAB 10/10/97
Common Excavation: 77SF
Earth Borrow: 34SF + 20SF = 54SF
25SF + 30SF = 55SF
Sheet 1 of 8
Original Section
Alignment Sta 10+50 to Sta 14+50
Final Plot 11-12-97