WORK ORDER NO.	DRAWING NO.	REV.
15717	E2	

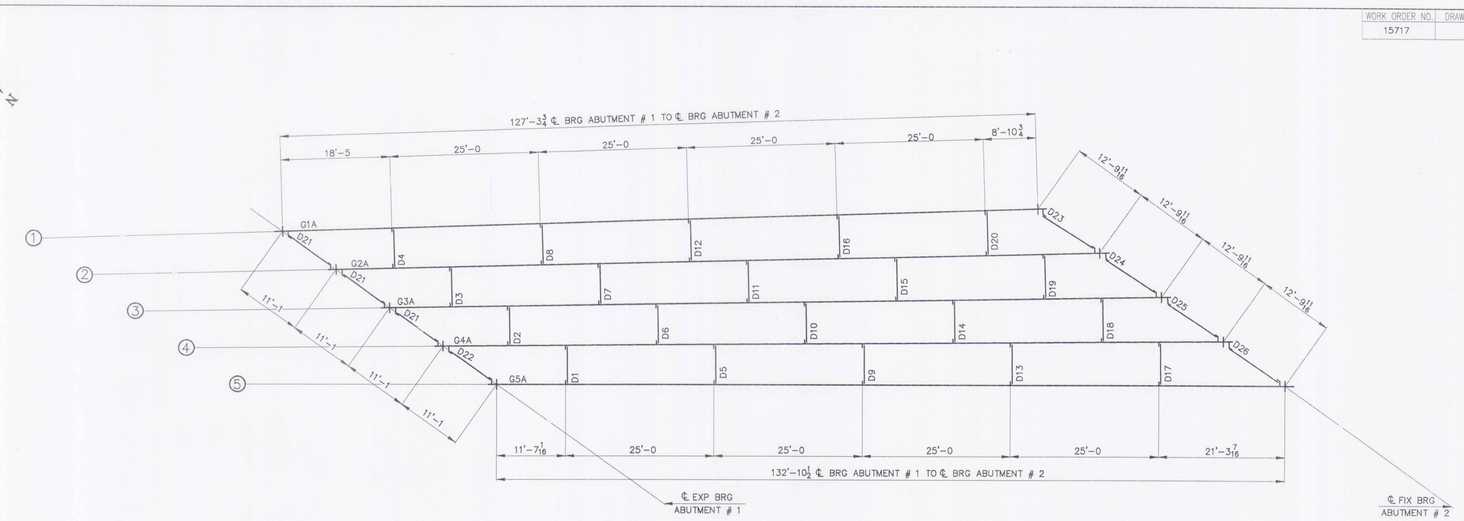

SPAN 1

STEEL FRAMING PLAN

NOTES

1. DIMENSIONS SHOWN ARE HORIZONTAL AND DO NOT REFLECT ANY CHANGE DUE TO GRADE.
2. GIRDERS ARE 49" WELDED PLATE GIRDERS.
3. SEE SHEET E1 FOR BRIDGE LAYOUT.

ITEM NO. 506.55	BRIDGE NO. 6		PROJ. NO. BRS 0187(6)
TITLE: STEEL FRAMING PLAN			
APPROVED: 11-25-96			National Eastern Corporation, Plainville, Connecticut
PRINT DIST.			
7	10/30/96	APPR.	
ORIG	12-1-96	FAB.	
01/0	6-2-97	VAT	JOB: VT ROUTE 12A OVER 3RD BRANCH OF THE WHITE RIVER BRAINTREE, VERMONT
			CUSTOMER: MILLER CONSTRUCTION, INC.
			DESIGNER: VERMONT AGENCY OF TRANSPORTATION
CHECKED	10/96	CSD	WORK ORDER NO. 15717 / DRAWING NO. E2 / REV.
DRAWN	10/96	CSD	