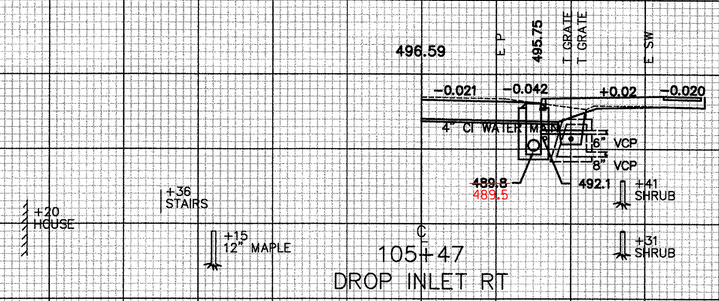

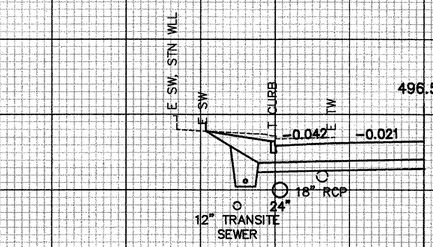

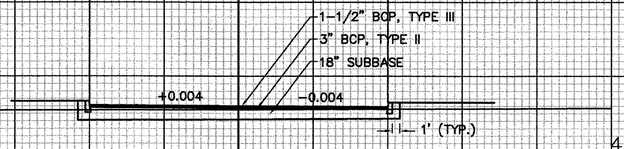

490

490

104+50
105+00
105+50

DRIVE DETAIL
STA 105+05 RT
SECTION A-A

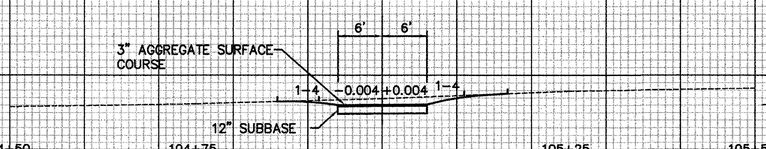

490

104+50
104+75
105+25

DRIVE DETAIL
STA 104+99 LT
SECTION B-B

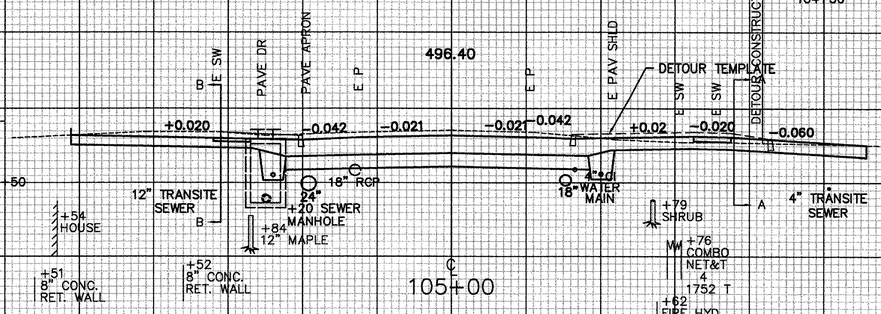

490

CROSS SECTIONS - ROUTE 15

FROM STA. 105+00 TO STA. 105+47
PROJECT NAME JOHNSON VT ROUTE 15
NO. BRF 030-2(17)S PLOTTED 12/30/87
SURVEYED BY SARGENT DEC. 1987
SHEET 74 OF 85 SHEETS

SCALE 10 FEET