ABM INFO		SHIP	BILL OF MATERIAL					JOB NO	DRAWING NO	REV
								323	2	
PAGE	LINE	MARK	QTY	MARK	MATERIAL	LENGTH FT	LENGTH INCHES	REMARKS	WT	PROCUREMENT NOTES
		2G2A	1		GIRDER				14425	
		2G3A	1		GIRDER				14425	
1	E		2	wa	PL $\frac{1}{2}$x27 $\frac{5}{8}$	76	6 $\frac{5}{16}$	(M270-50T2) (H2-3)		
1	C		2	ta	PL $\frac{7}{8}$x16	76	6 $\frac{5}{16}$			
1	A		2	ba	PL 1 $\frac{1}{2}$x18	76	5 $\frac{5}{8}$	(M270-50T2) (H2-3)		
2	B		8	x1a	PL $\frac{1}{2}$x5	2	3 $\frac{5}{8}$			
2	B		8	x1b	PL $\frac{1}{2}$x5	2	3 $\frac{5}{8}$			

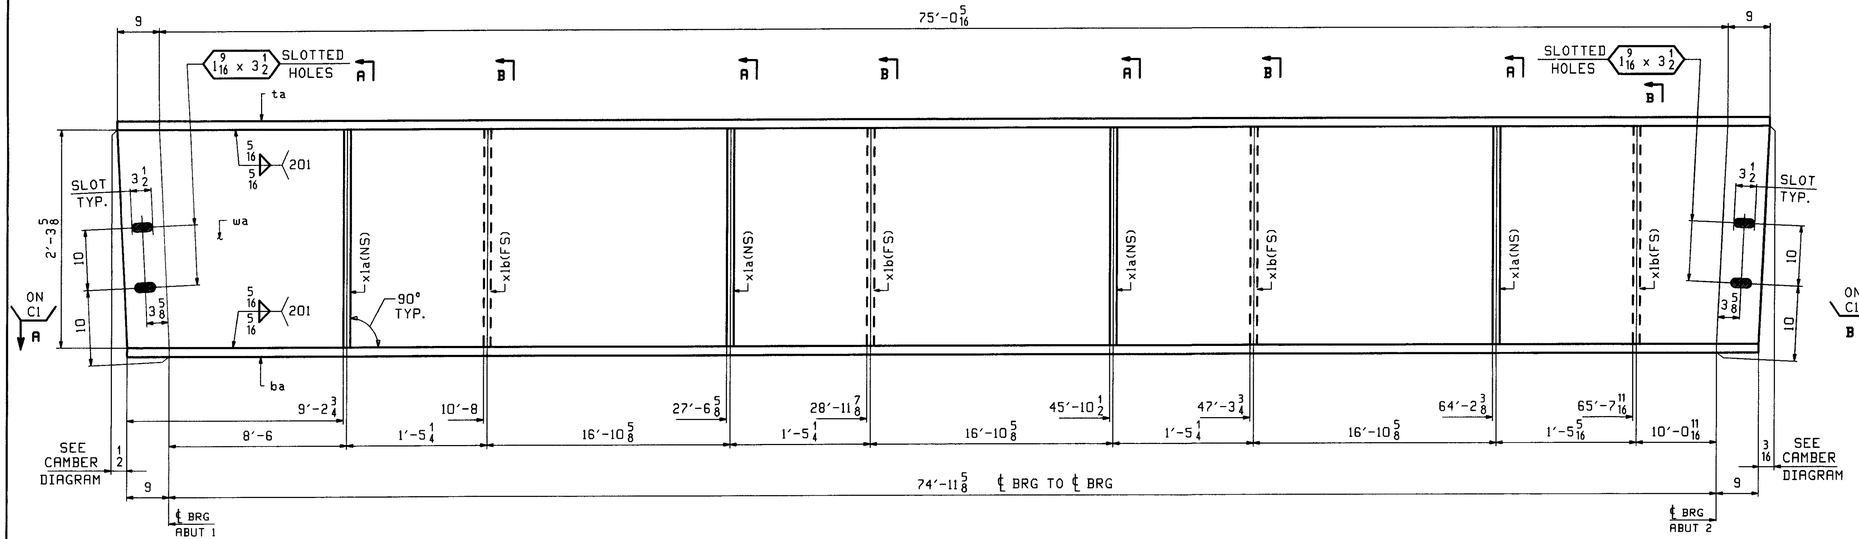

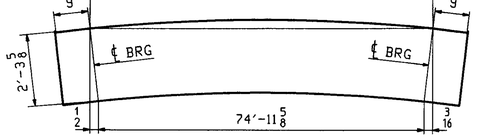

ORIENTATION DIAGRAM

ONE - GIRDER - 2G2A
ONE - GIRDER - 2G3A
] ALIKE EXCEPT FOR MARK

FOR GIRDER STANDARD DETAILS SEE DRAWING X1.
FOR CAMBER DIAGRAM SEE DRAWING C1.
FOR GENERAL NOTES SEE DRAWING GN1.
H2-3 DENOTES MATERIAL SUBJECT TO CHARPY V-NOTCH TESTING.

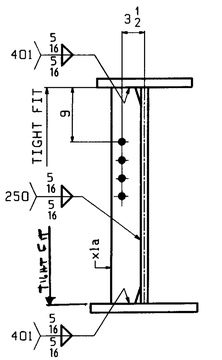

SECTION-A

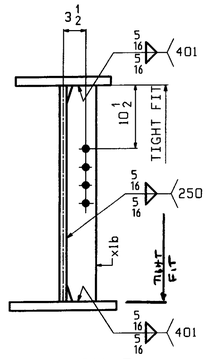

SECTION-B

RECEIVED
CK'D BY CLD OK'D BY
JUN 0 1 2007
RESUBMIT APPROVED As Noted
BY WJG DATE 6/27/07

REV.	REMARKS	DATE	DWN	CHK	APP	Q.A.	NO.	DIA.	LGT	TYPE	WASHER
	OUT FOR APPROVAL	5-24-07									
	OUT FOR APPROVAL										
	ISSUED TO SHOP										
	FIELD & OFFICE										

MATERIAL (UN):	ELECTRODES	HOLES	SHOP BOLTS
M270 GR. 50		15/16ø (UN)	NONE

SURFACE PREP & PAINT:
SEE PAINT NOTES ON DWG GN1

DESCRIPTION: GIRDER - 2G2A & 2G3A	DRAWN BY	DATE
JOB: VT ROUTE 15 OVER THE GIHON RIVER BRIDGE NO 37 TOWN OF JOHNSON, VT (LAMOILLE COUNTY)	WR	05/17
	CHKD BY	
	DO	05/21
TENSOR 2716	APPROV BY	
	SUPERVISOR	W J GATTI
PROJ NO. BRF 030-2(17)S	Q.A.	
CUSTOMER: VT A.O.T		

CASCO BAY STEEL STRUCTURES, INC.
75 SPRING HILL ROAD SACO, MAINE 04072
PHONE (207) 282-7360 FAX. (207) 282-1179

JOB NO.	DRG. NO.
323	2
	REV. △

Tue, May 22, 2007 03:24:05 PM c:\users\jake\2716\2 Rev0
WR