U. S. ROAD	STATE	FED. AID PROJ. NO.	FISCAL YEAR	SHEET NO.	TOTAL SHEETS
	VT.	46		8	9

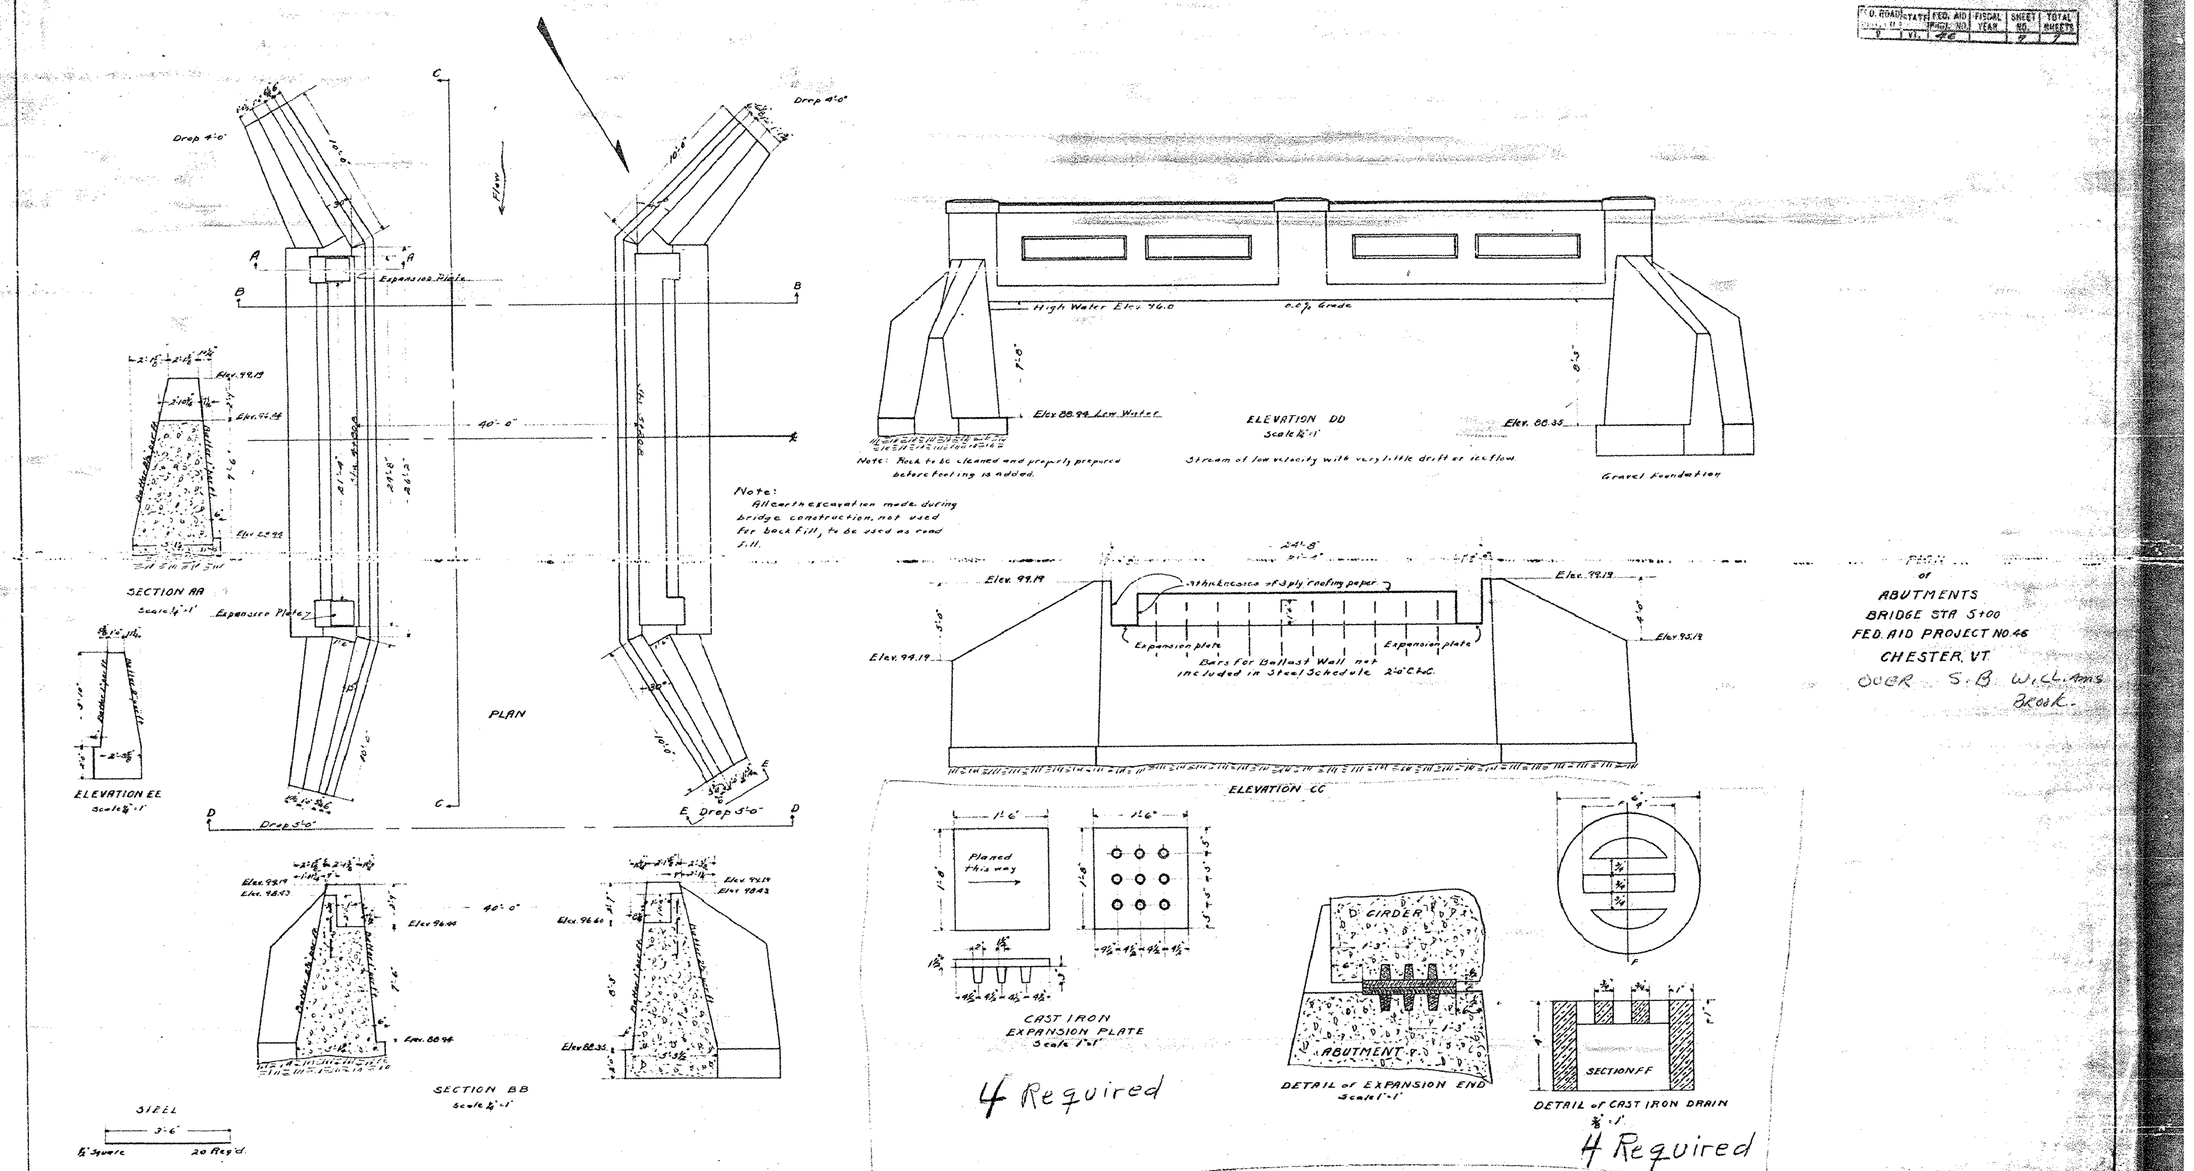

MATERIAL

Steel	60#
4 Cast Iron Plates	652#
4 " " Gratings	72#
1-2-4 Concrete in Ballast Wall	2.7 cu. yds
1-2½-5 " " Abuts. and Wings	113.8 "

N. T. S.

PROJECT NAME: CHESTER	
PROJECT NUMBER: BRF 025-1(28)	
FILE NAME: 84e061/Str/s84e061scans.dgn	PLOT DATE: 20-SEP-2010
PROJECT LEADER: C.P.WILLIAMS	DRAWN BY:
DESIGNED BY:	CHECKED BY:
BRIDGE 8 REFERENCE PLANS	SHEET 56 OF 124