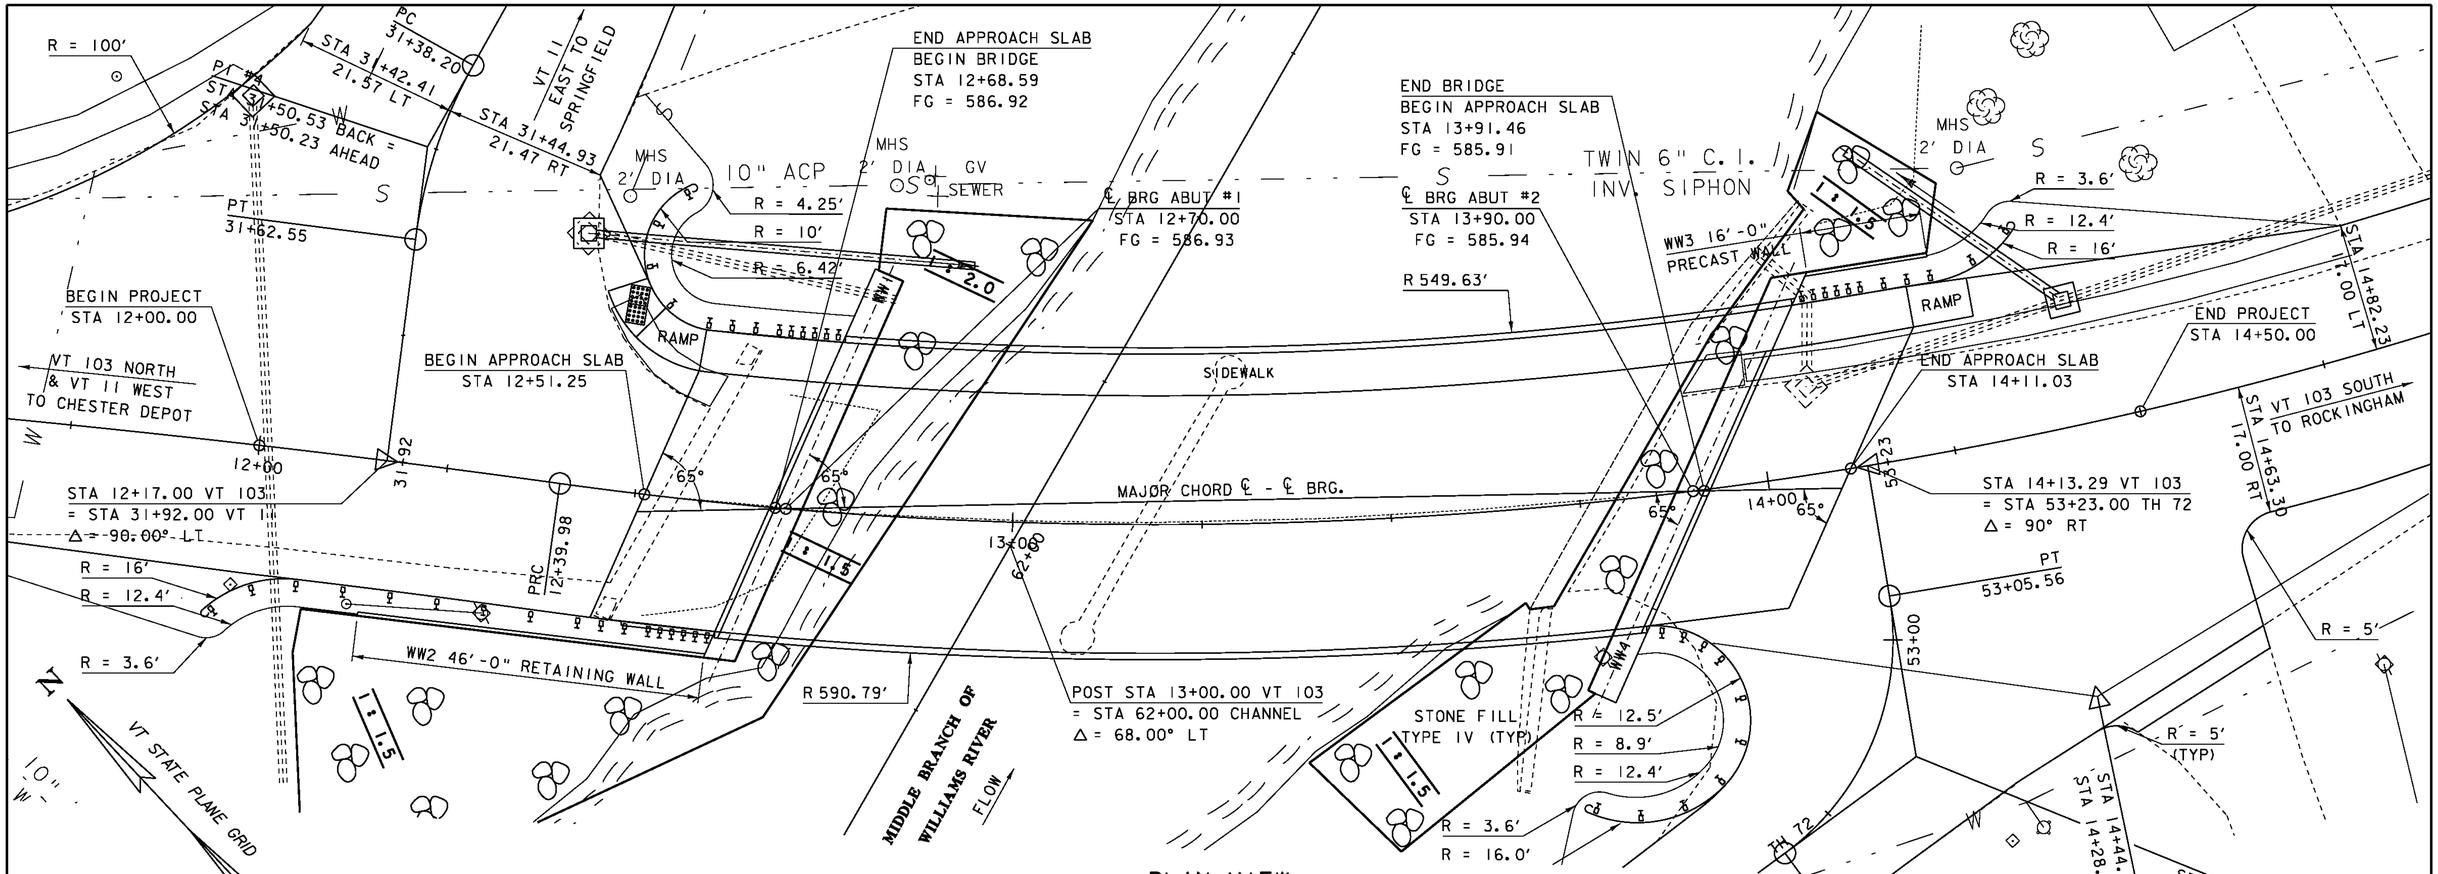

PLAN VIEW

SCALE 1" = 10'-0"

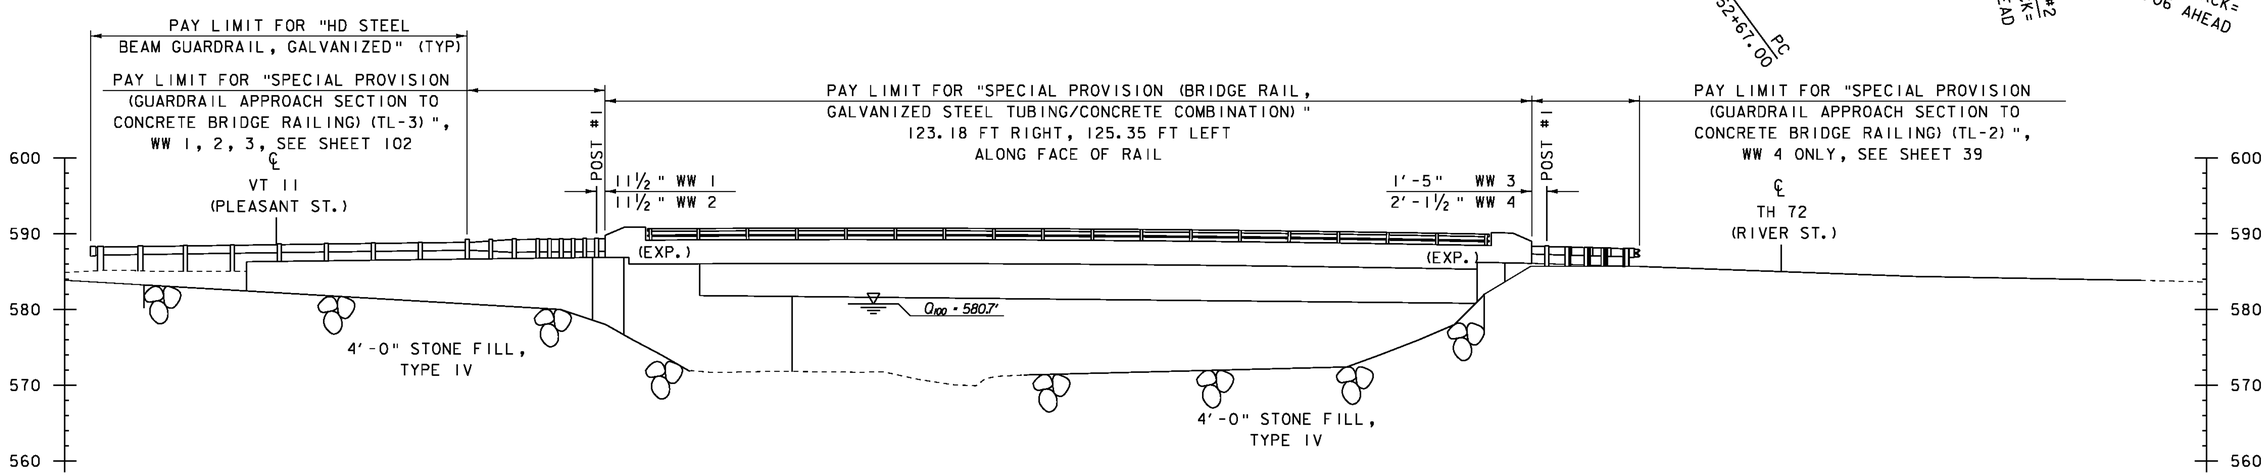

ELEVATION AT UPSTREAM FASCIA

SCALE 1" = 10'-0"

SCALE 1" = 10'-0"
10 0 10

PROJECT NAME: CHESTER	
PROJECT NUMBER: BRF 025-1(37)	
FILE NAME: s95b168pe.dgn	PLOT DATE: 20-SEP-2010
PROJECT LEADER: C.P.WILLIAMS	DRAWN BY: D.D.BEARD
DESIGNED BY: R.S.YOUNG	CHECKED BY: H.J.SALLS
BRIDGE 9 PLAN AND ELEVATION	SHEET 78 OF 124