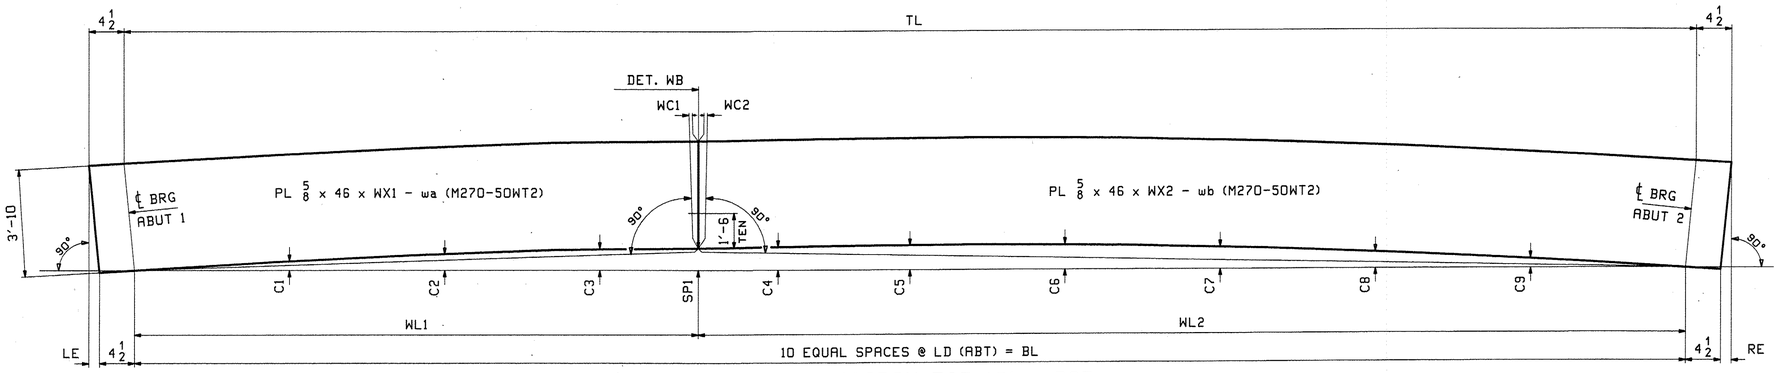

CAMBER DIAGRAM FOR 1G1 - 7G7

MARK	TL	BL	LE	RE	WL1	WL2	WX1	WX2	SP1	WC1	WC2	LD	C1	C2	C3	C4	C5	C6	C7	C8	C9	PG/LINE	PG/LINE
1G1	121'-1 1/4	121'-0 1/8	1 1/16	1/16	41'-1 1/2	79'-10 5/8	41'-7 1/8	80'-3 5/8	8 15/16	13/16	7/16	12'-1 1/4	3 7/16	6 1/4	8 7/16	9 3/4	10 3/16	9 13/16	8 1/2	6 5/16	3 1/2	2/ L	1/ U
2G2	120'-9 7/16	120'-8 1/4	1 1/16	1/8	41'-1 1/2	79'-6 3/4	41'-7 1/8	79'-11 3/4	9 3/16	7/8	7/16	12'-0 7/8	3 9/16	6 7/16	8 5/8	10	10 3/8	9 15/16	8 5/8	6 3/8	3 1/2	2/ L	1/ W
3G3	120'-5 3/4	120'-4 9/16	1 1/16	1/8	41'-1 1/2	79'-3 1/16	41'-7 1/8	79'-8 1/16	9 7/16	7/8	7/16	12'-0 1/2	3 11/16	6 5/8	8 7/8	10 1/4	10 5/8	10 1/8	8 3/4	6 1/2	3 1/2	2/ L	1/ Y
4G4	120'-2 1/4	120'-1	1 1/16	3/16	41'-1 1/2	78'-11 1/2	41'-7 3/16	79'-4 1/2	9 11/16	7/8	1/2	12'-0 1/8	3 3/4	6 13/16	9 1/8	10 1/2	10 15/16	10 3/8	8 7/8	6 9/16	3 9/16	2/ L	2/ A
5G5	119'-10 7/8	119'-9 9/16	1 1/16	1/4	50'-7 1/2	69'-2 1/16	51'-1 3/16	69'-7 1/4	10 15/16	13/16	5/8	11'-11 3/4	3 7/8	6 15/16	9 5/16	10 13/16	11 1/4	10 11/16	9 1/8	6 3/4	3 11/16	2/ J	2/ G
6G6	119'-7 11/16	119'-6 5/16	1 1/16	5/16	50'-7 1/2	68'-10 13/16	51'-1 3/16	69'-4	11 1/4	7/8	5/8	11'-11 3/8	3 15/16	7 1/8	9 5/8	11 1/8	11 9/16	11 1/16	9 1/2	7	3 13/16	2/ J	2/ E
7G7	119'-4 9/16	119'-3	1 1/16	1/2	50'-7 1/2	68'-7 1/2	51'-1 3/16	69'-0 3/4	11 9/16	7/8	5/8	11'-11 1/8	4	7 5/16	9 7/8	11 7/16	11 15/16	11 7/16	9 7/8	7 5/16	4 1/16	2/ J	2/ C

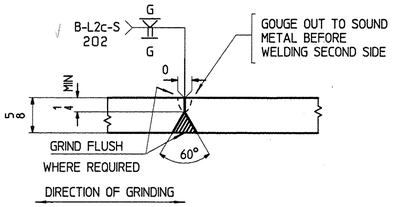

WEB PLATE SPLICE DETAIL "WB"

RECEIVED
CK'D BY EJC DATE BY RST
DEC 14 2010
RESUBMIT APPROVED As Noted
BY CPW DATE 12/30/10

FOR GENERAL NOTES SEE SHEET GN1

REV.	DATE	REMARKS	DWN	CHK	APVL	SHOP
0						

MATERIAL:	SURFACE PREP. & PAINT:	HOLES:	SHOP BOLTS:
M270-GR50WT2	SSPC-SP6	N/A	N/A

DESCRIPTION: CAMBER DIAGRAM

CASCO BAY STEEL STRUCTURES, INC.
75 SPRING HILL ROAD SACO, MAINE 04072
PHONE (207) 282-7360 FAX. (207) 282-1179

TENSOR 3030

STRUCTURE: VT 103 over Middle Branch Williams Rv.
Bridge 9
CHESTER
County of Windsor

DRAWN: TG DATE: 11/18
CHK'D: DO DATE: 11/30

LOCATION: Town of Chester
PROJ NO. BRF 025-1(37)
CUSTOMER: Cold River Bridges

JOB NO. 476
DWG NO. C1
REV. △

Fri, Dec 3, 2010 02:30:51 PM J:\users\jobs\3030\C1 | Rev0