END ROW PROJECT
BRS 0169(6)
STA. 5+340.000 7.544M (24.75') LT.

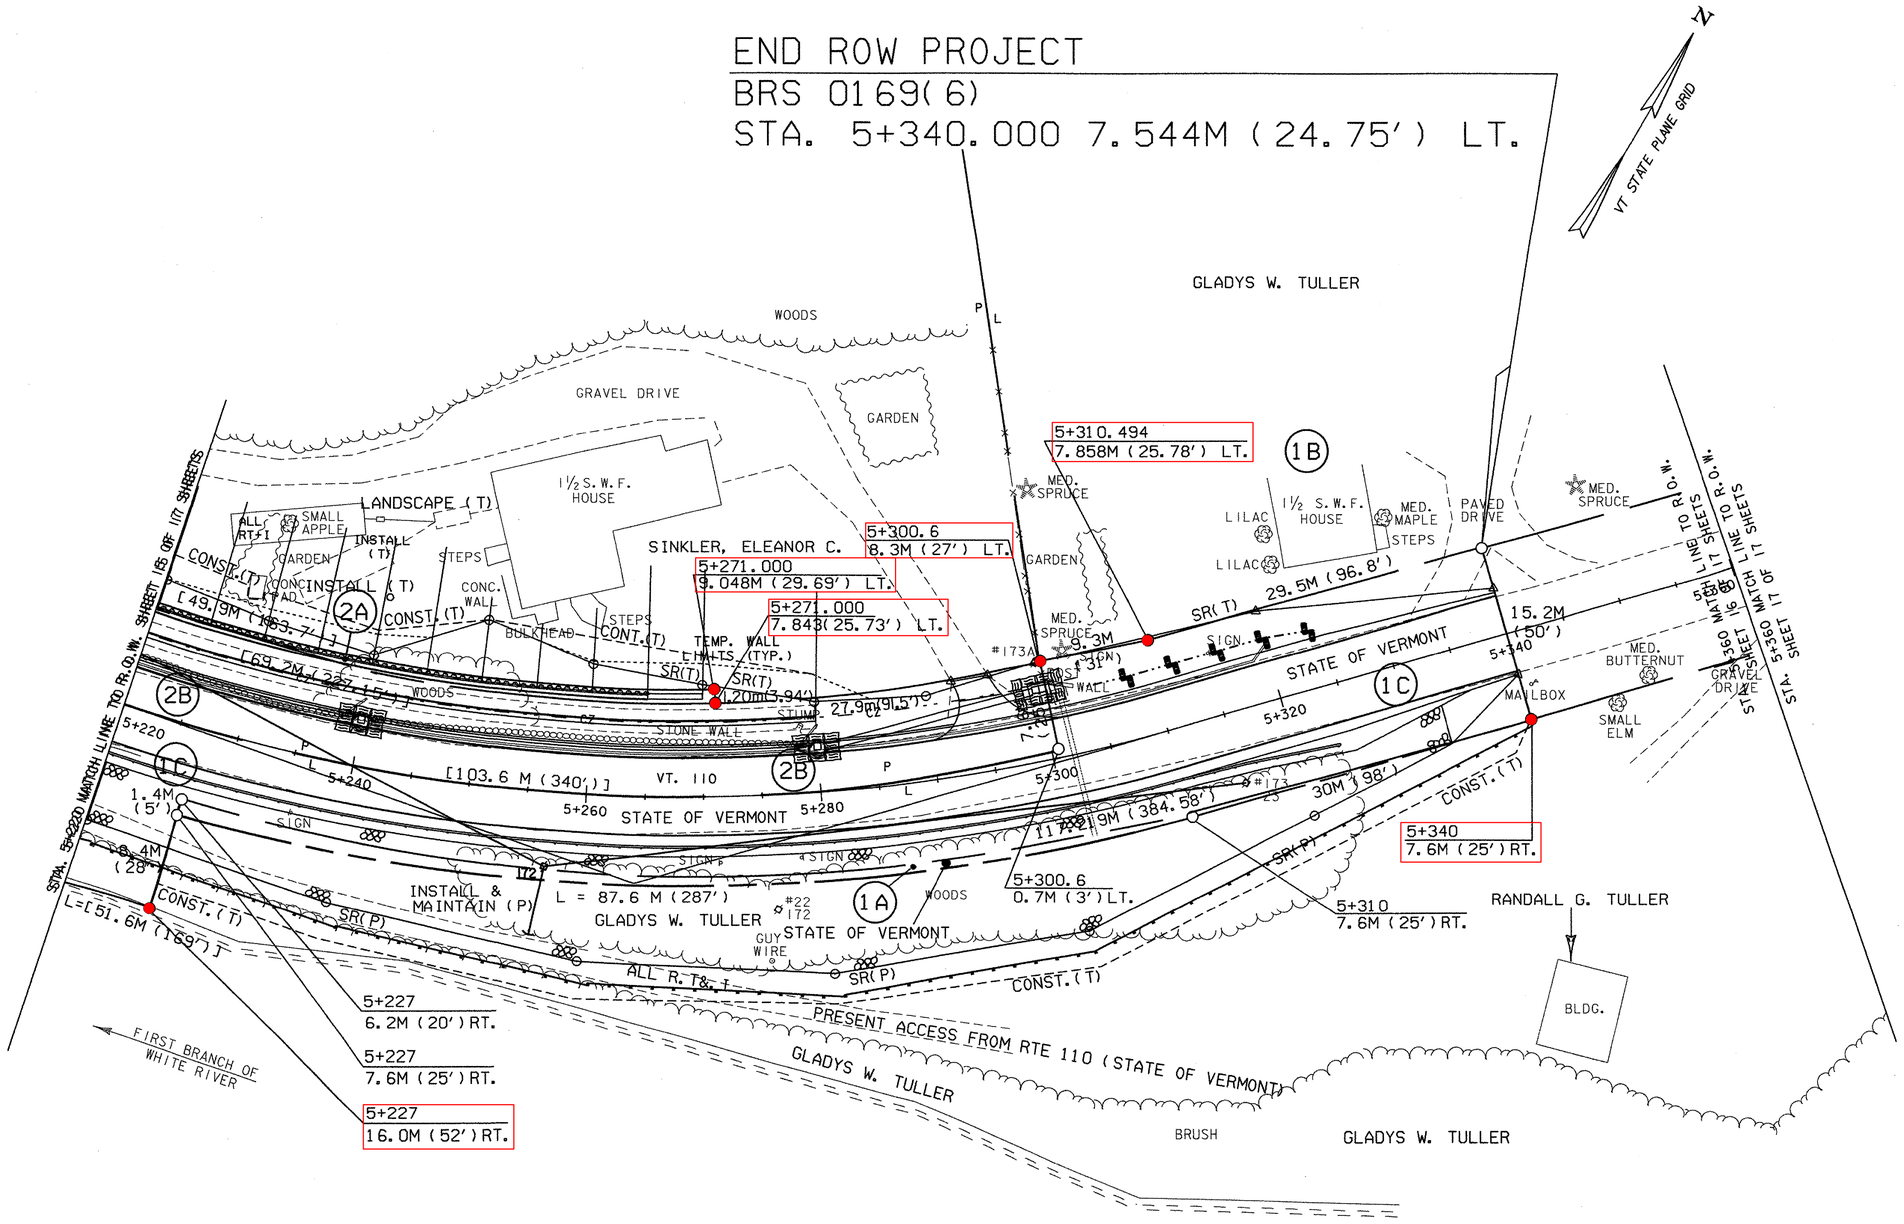

FOR EROSION CONTROL DETAILS AND NEW DRAINAGE NOTES SEE R.O.W. SHEET 11 OF 17

LINES SHOWN ON THIS PLAN AS EXISTING PROPERTY LINES (P/L) ARE BELIEVED TO BE ACCURATE BUT SHOULD NOT BE RELIED UPON FOR PURPOSES UNRELATED TO THE STATE OF VERMONT'S ACQUISITION OF LAND AND RIGHTS FOR THIS PROJECT.

BOUNDS SET

0 10 20 30

SCALE IN METERS

/84e063/str/re063rb2.i

PROJECT NAME: TUNBRIDGE
PROJECT NUMBER: BRS 0169(6)

FILE NAME: /84e063/str/se063bdr.dgn
PROJECT LEADER: PORTALUPI
DESIGNED BY:
PLOT DATE: 30-MAR-2005
DRAWN BY: L. BULLOCK
CHECKED BY:

R.O.W. SHEET 16 OF 17 SHEETS