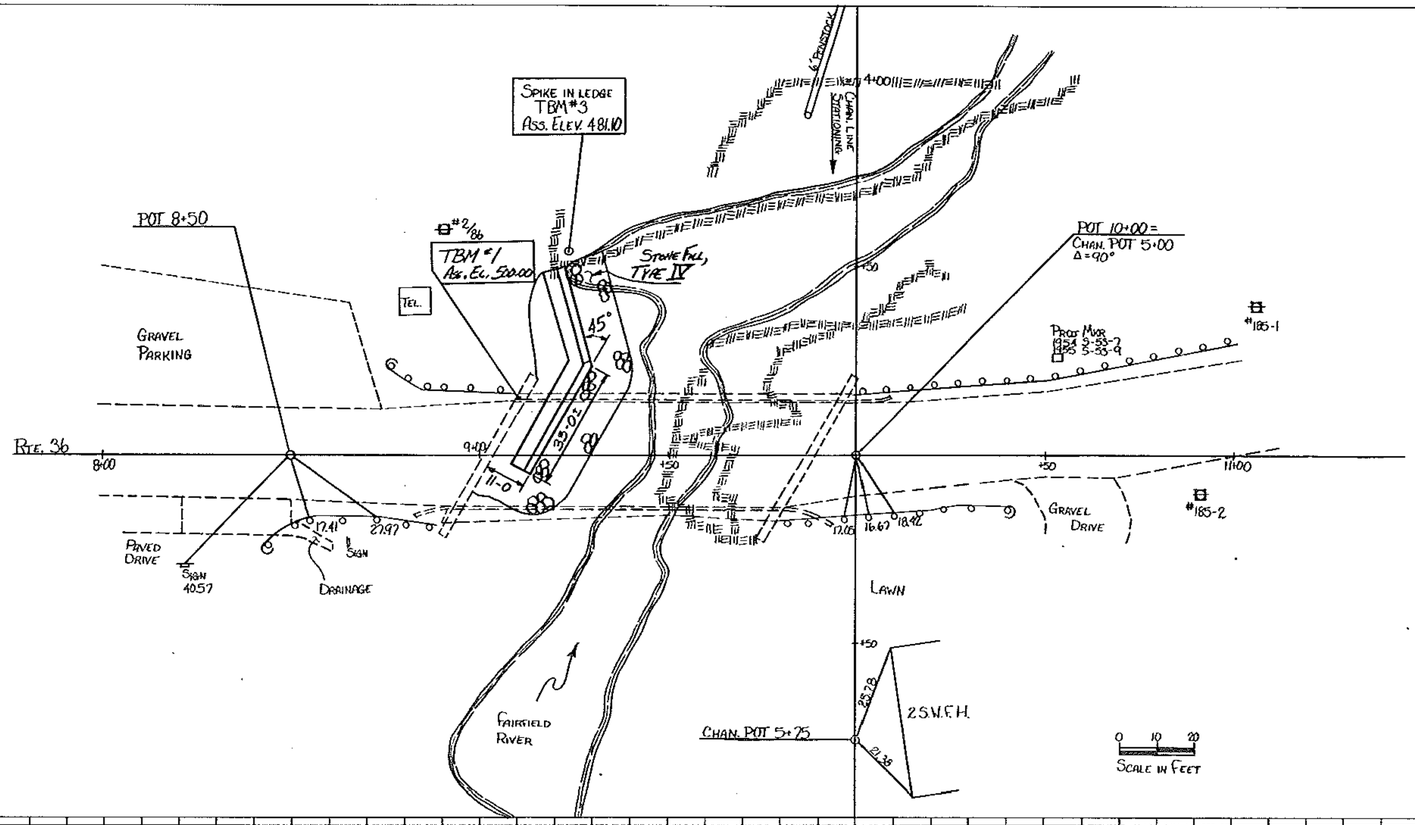

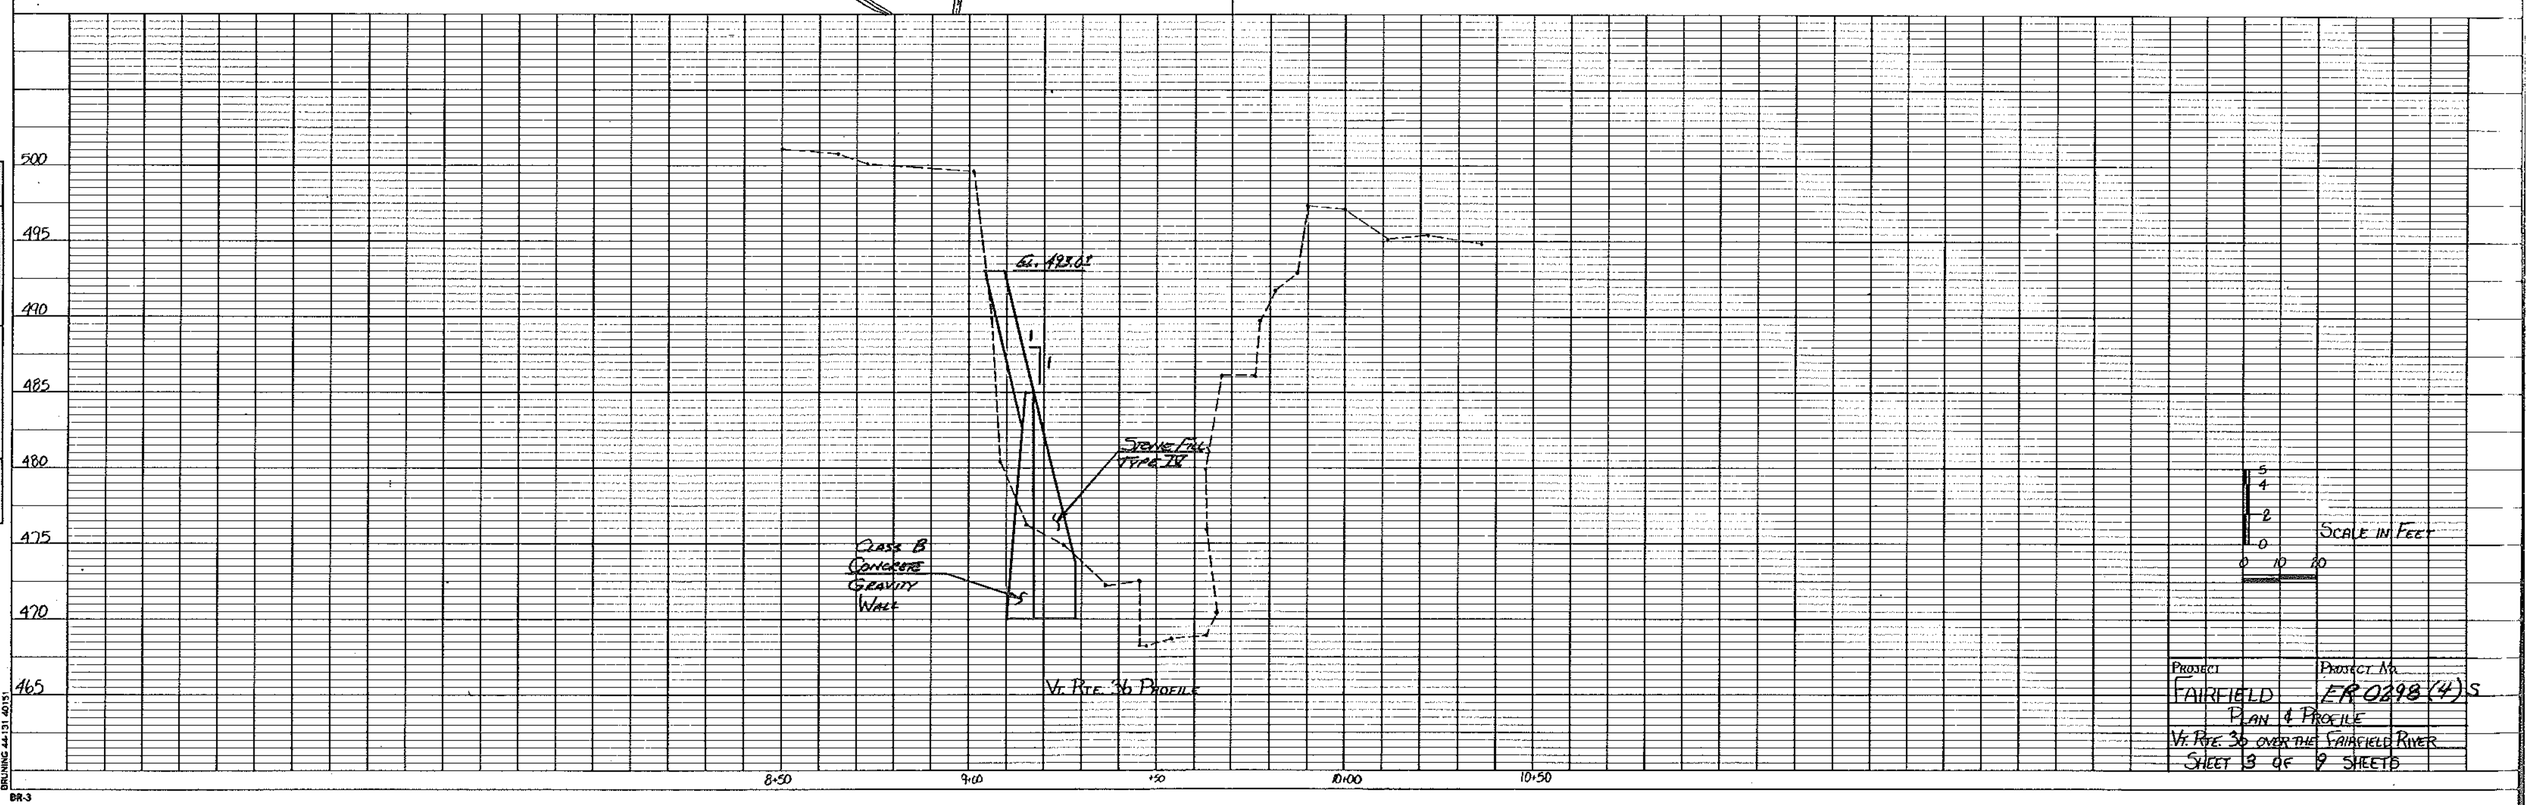

PROJECT: FAIRFIELD
PROJECT NO. ER 0298 (4) S
PLAN & PROFILE
VT. RTE. 36 OVER THE FAIRFIELD RIVER
SHEET 3 OF 9 SHEETS

PLAN
SURVEYED
PLOTTED
ALIGNMENT CHECKED
RT. OF WAY CHECKED
NOTE BOOK NO.
CAUTION: ABOVE LINES

PROFILE
SURVEYED
PLOTTED
GRADES CHECKED
B.M.'s NOTED
STRUCTURE NOTATNS CHKD
NOTE BOOK NO.

BRUNING 44-131 40151
BR-3